


Section 23 Township 9 Range 19WWell No. #1 F. CerrowCompany Stanolind

NORTH

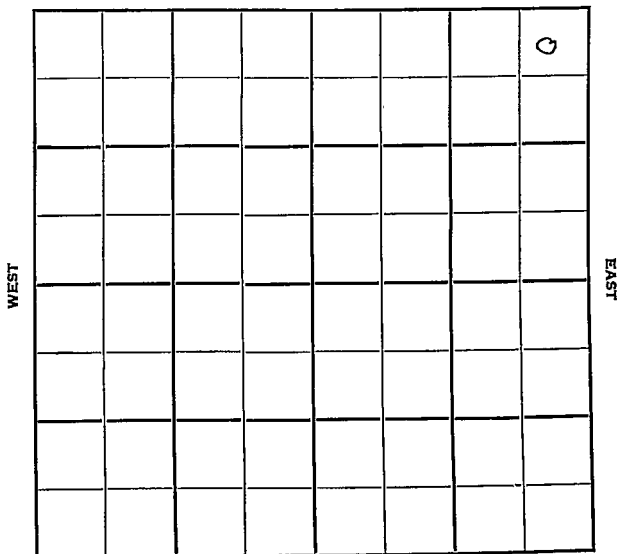

SOUTH

Rooks

KANSAS

Sec. 23 Twp. 9 R. 19W

Well No. #4 F. Cerron Farm .

Stanolind _____ Company

Contractor


330' Ft. from N. Line

Ft. from S. Line

330' Ft. from E. Line

Ft. from W. Line

NE NE NE

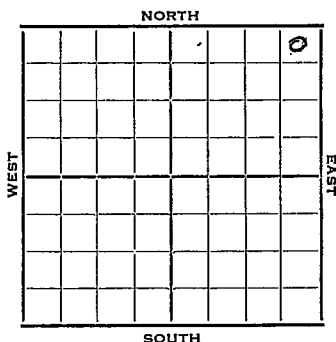

1952

Elev. 2088'

REPORT

4/16	Location
------	----------

4/23

4/30 | MIR

5/7 10" @ 164'

Anhy 1475'

Drlg. 3015:

5/14 Topeka 3015' Heeb 3221' Lans. 3265'
RTD 3510' 5" @ 3507' WOCT

RTD 3510' 5" @ 3507' WOCT

5/21 CO 3510 S/10 BOPH 5/8 BFPH for
9 hrs. 10% wtr POP

9 hrs. 10% wtr POP

5/28 NR

6/11 Spud 4-25-52

Oil well TD 3510' 10" @ 164

Anhy 1475' Top. 3015' Heeb 3221'

Lans. 3265'

DST 3495-3505 open $\frac{1}{2}$ hr. rec 30' mud

DST 3505-08 open 1 hr, rec 15' mud

DST 3495-3508 open 3/4 hr. rec 90' mud

DST 3505-10 open 3/4 hr. rec 30' mud

TD 3510 5th @ 3507 CO to 3510

S/10 BOPH S/8 BFPH 10% water

P/100 BF 20 hr.

Comp. 33 BOPD 65 BW

COMPLETED

County Rooks State KansasSec. 23 (Blk.) 9 (Sur.) 19N Map No.Operator StanolindWell No. 4 Farm F. GerrowElev. Location NE NE NE

							0

FIRST REPORT

330 Ft. From N Line NE330 Ft. From E Line Quarter1st. Report APR 16 1952

Completion

Remarks

Spudding Date

Drlg. Data

Location

J. G. McGEHEE

County Rooks State Kansas
 Sec. 23 (Blk. 9) (Sur. 19W) Map No. _____
 Operator Stanolind
 Well No. 4 Farm F. Cerrow
 Elev. 2088 Location NE NE NE

						0

330 Ft. From N Line NE

330 Ft. From E Line Quarter

1st. Report

Completion JUN 11 1952

Remarks

Spudding Date 4-25-52

Drig. Data Oil well TD 3510

10" @ 164 Anhy 1475 Top. 3015

Heeb. 3221 Lans. 3265 DST 3495-3505

open $\frac{1}{2}$ hr. Rec. 30' mud DST 3505-08

open 1 hr. Rec. 15' mud DST 3495-3508

open $\frac{3}{4}$ hr. Rec. 90' mud DST 3505-10open $\frac{3}{4}$ hr. Rec. 30' mud TD 3510

5" @ 3507 CO to 3510 S/ 10 boph

S/ 8 bfph 10% water P/ 100 bf 20 hr.

Comp. 33 bopd 65 bw

J. G. McGEHEE