

Section 23 Township 9 Range 19W

Well No. 1 Jelinek

Company Derby et al

9

NORTH

						o	

WEST

EAST

SOUTH

Sec. 23 Twp. 9 R. 19W

Well No. #1 Jelinek Farm

Derby etal Company

Wildcat


330 Ft. from N. Line

_____ Ft. from S. Line

990 Ft. from E. Line

_____ Ft. from W. Line

NW NE SE

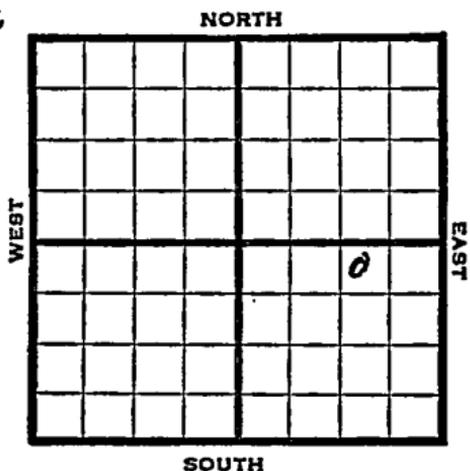

1947 Elev. 2124' REPORT

11/5 8" @ 281 WOC

11/12 Drlg. 1655'

11/19 Lansing 3301'
Drlg. 3375'

11/25 Arbuckle 3541'
TD 3544'
5" @ 3542'
RUST

12/3 TD 3553' swb 13 bbls oil 1 hr.
1500 Acid

12/10 Swb. 45 bbls. oil PH 2 hrs.

12/30 Arb. 3541'
5" @ 3542'
2000 acid
Echo Pot 2292'
22.0 Gr.
TD 3552'

COMPLETED

Map No. _____ Sec. 23 Twp. 9 R. 19W

Well No. 1 Jelinek

Derby et al. _____ Company

FIRST REPORT _____ Contractor

NW NE SE


SECTION PLAT

330 Ft. from N. Line

_____ Ft. from S. Line

990 Ft. from E. Line

_____ Ft. from W. Line

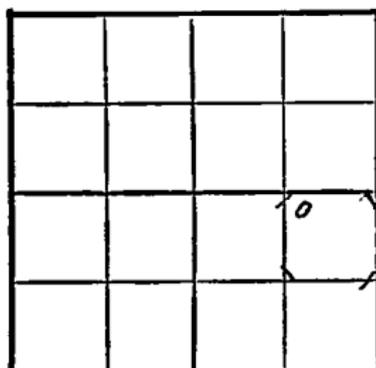

Rooks County

Location _____

Rig up _____

Drilling and Remarks:

8" @ 281 WOC

RECORD

Cased _____ in., _____ ft.

Sand _____

Gas _____

Oil _____

Total Depth _____

PRODUCTION

1st 24 hrs. Nat. _____

1st 24 hrs. after shot _____

Gas _____ Cu. Ft.

Dry Hole _____

Abandoned _____

Date

NOV 5 1947 19

S. J. LEWIS Scout

Map No. 65 Sec. 23 Twp. 9 R. 19W

Well No. 1 Jelinek

Derby et al. Company

COMPLETE

Contractor

E. 12124

NW NE SE

SECTION PLAT

330 Ft. from N. Line

_____ Ft. from S. Line

990 Ft. from E. Line

_____ Ft. from W. Line

			0

Rooks County

RECORD

Location _____

Cased _____ in., _____ ft.

Rig up _____

Sand _____

Drilling and Remarks:

Gas _____

Core 43541

Oil _____

5" core 542

Total Depth 2052

2000 acid

Echro 8082292

PRODUCTION

1st 24 hrs. Nat. _____

1st 24 hrs. after shot _____

Gas _____ Cu. Ft.

Dry Hole _____

Abandoned _____

22° SW

Date

DEC 30 1947 19

S. J. LEWIS Scout