


KANSAS

Company Dervy & Peel
Paradise Pool

NORTH

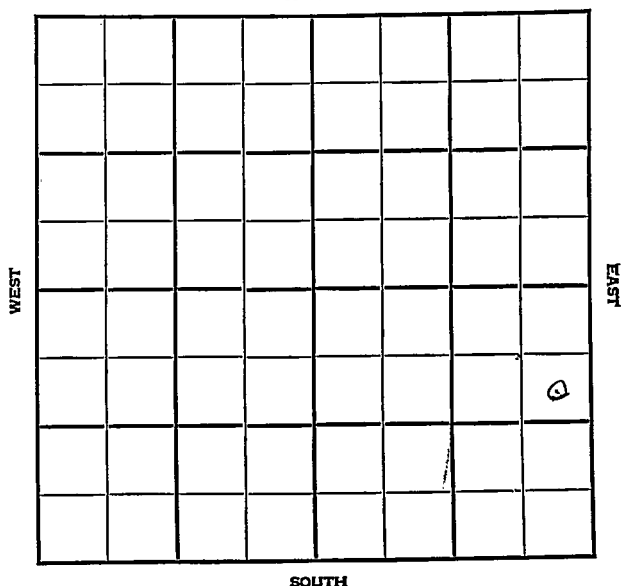

KANSAS

Rook County



Sec. 23 Twp. 9 R. 19W

Well No. #2 Jelinek Farm

Derby & Peel

Company

Paradise Pool

990' Ft. from N. Line


1

Ft. from S. Line

330' Ft. from E. Line

Ft. from W. Line

SE NE SE

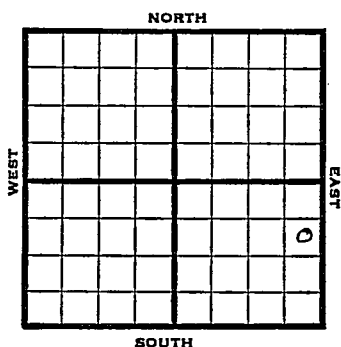

1948

Elev. 2137' REPORT

4/21

Location

4/28

8" @ 257'
WOC

5/5

Drlg. 2734'

5/12

Lansing 3403'
Arbuckle 3547'
RUST

5/19

TD 3558 $\frac{1}{2}$ - 1000 acid
Swb 51 bbls oil PH

6/1

Arbuckle 3547'
5" @ 3547'
Acid 1000
Depth Pot. 3000 Oil
Gr. 29°
TD 3558 $\frac{1}{2}$

COMPLETED

Map No. _____ Sec. 23 Twp. 9 R. 19WWell No. 2 JelinekDerby & Peel

Company

FIRST REPORT

Contractor

SE NE SE

SECTION PLAT

990 Ft. from N. Line

Ft. from S. Line

330 Ft. from E. Line

Ft. from W. Line

Rooks CountyLocation X

Rig up _____

Drilling and Remarks:

RECORD

Cased _____ in., _____ ft.

Sand _____

Gas _____

Oil _____

Total Depth _____

PRODUCTION

1st 24 hrs. Nat. _____

1st 24 hrs. after shot _____

Gas _____ Cu. Ft.

Dry Hole _____

Abandoned _____

Date

APR 21 1948

19

S. J. LEWIS

Scout

Map No. 65 Sec. 23 Twp. 9 R. 19W

Well No. 2 Jelinek

Derby & Peel Company

COMPLETE

Contractor

SE NE SE

E 12137

SECTION PLAT

990 Ft. from N. Line

 Ft. from S. Line

330 Ft. from E. Line

 Ft. from W. Line

Rooks County

Location

Rig up

Drilling and Remarks:

Cor 83547

5" 83547

1000000

Depth 283000 ft

29° E

RECORD

Cased in., ft.

Sand

Gas

Oil ✓

Total Depth 3558 1/2

PRODUCTION

1st 24 hrs. Nat.

1st 24 hrs. after shot

Gas Cu. Ft.

Dry Hole

Abandoned

Date

JUN 1 1948 19 S. J. LEWIS Scout