


Section 23 Township 9 Range 19 W

Well No. #3 Sainden

Company Murfin & Patton 15

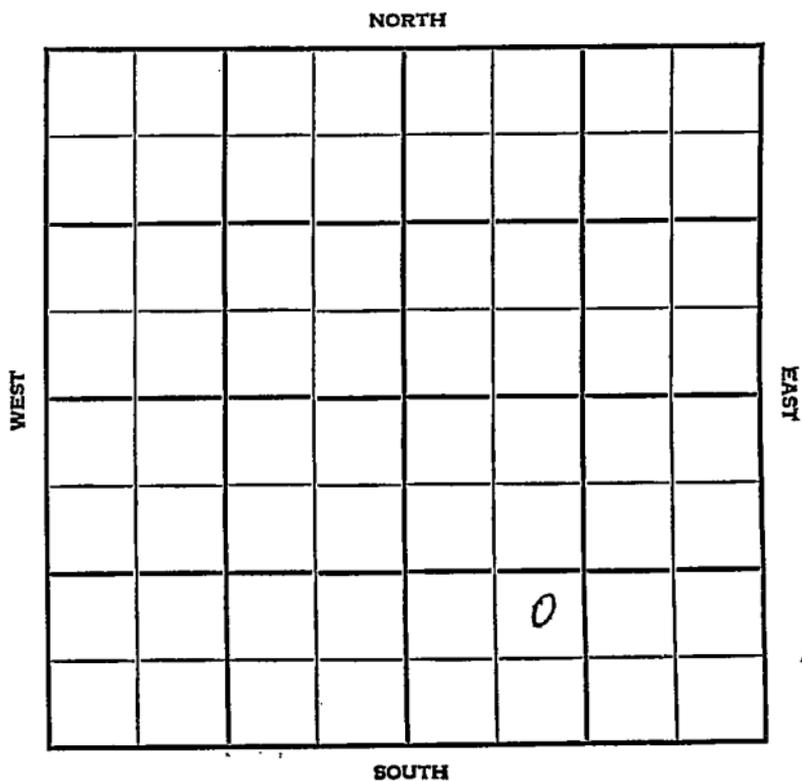

Rooks

KANSAS

|      |      |      |
|------|------|------|
| SEC. | TWP. | R.   |
| 23   | 9    | 19 W |

WELL NO.

# 3 Sainden

FARM

COMPANY

Murfin &amp; Patton

CONTRACTOR

Murfin

Chandler Pool


\_\_\_\_\_ Ft. from N. Line

990 \_\_\_\_\_ Ft. from S. Line

\_\_\_\_\_ Ft. from E. Line

990 \_\_\_\_\_ Ft. from W. Line

NE SW SE

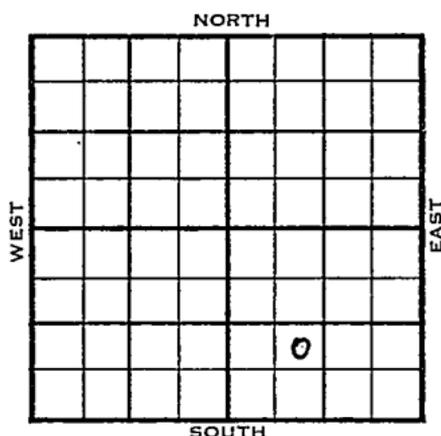

|      | ELEVATION | REPORT |
|------|-----------|--------|
| 1954 | 2135'     |        |

9/22 Spud 9-20-54  
Drlg. 150'

10/6 Spud 9-20-54 - D&A  
TD 3569'  
8" @ 182'  
Anhy 1509', Top. 3063', Heeb 3271',  
Tor 3287', Lans 3311', Cong 3550',  
Simp. 3557', Arb. 3565'  
DST 3566-69', opn  $\frac{1}{2}$  hrs., rec. 25'  
wtr, socm, 250' muddy SW, 380#  
TD 3569'  
D&A

**ABANDONED**



