


KANSAS

Graham

Section 23 Township 9 Range 21W

Well No. #2 Ballhazor

Company Frank Bubtram

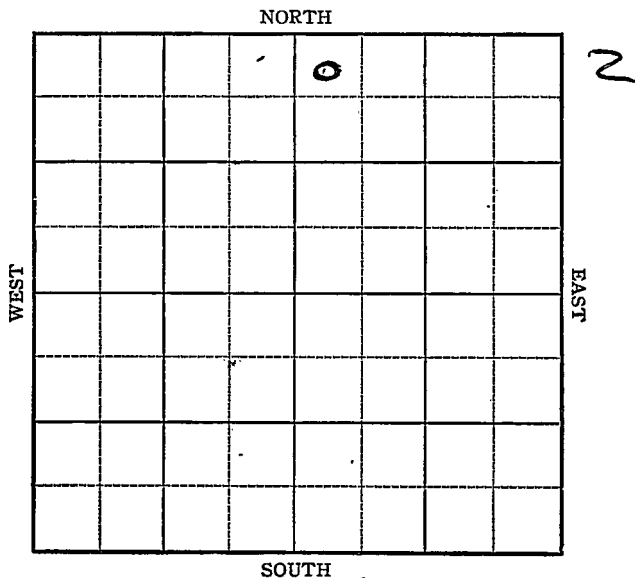

Sec. 23 Twp. 9 R. 21W

Well No. #2 Ballhazor Farm

Frank Buttram Company

Morel Pool


330 Ft. from N. Line

_____ Ft. from S. Line

_____ Ft. from E. Line

330 Ft. from W. Line

elev. 2269

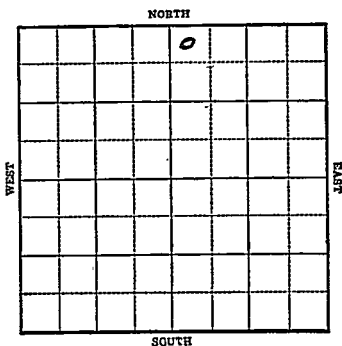

1944

R E P O R T

2/23	Rotary
3/3	8" @ 1664 TD 1710' WOC.
3/8	Drlg. 2910'
3/16	3576 Fishing
3/22	Drlg. 3675'
3/29	3722 fsg.
4/5	Cong 3715 Arb 3768 TD 3772 5" @ 3769 SO Rust
4/12	5" @ 3768 Arb 3768 TD 3773 1000 acid Depth Pot 11895 Max 3000 Gravity 30.2

COMPLETED

KANSAS

Map No. 62 Sec. 23 Twp. 9 R. 21W

Well No. 2 Ballhazor

Frank Buttram Company

FIRST REPORT Contractor

NW NE

SECTION PLAT

330 Ft. from N. Line

_____ Ft. from S. Line

_____ Ft. from E. Line

330 Ft. from W. Line

		o	

Morel Pool

Location _____

Rig up _____

Drilling and Remarks:

Rotary

RECORD

Cased _____ in., _____ ft.

Sand _____

Gas _____

Oil _____

Total Depth _____

PRODUCTION

1st 24 hrs. Nat. _____

1st 24 hrs. after shot _____

Gas _____ Cu. Ft.

Dry Hole _____

Abandoned _____

Date

FEB 23 1944

19

S. I. LEWIS

Scout

Graham

KANSAS
 Map No. 65 Sec. 23 Twp. 9 R. 21W

Well No. 2 Balthazor

Frank Buthram Company

COMPLETED Contractor

NW NE

SECTION PLAT

330 Ft. from N. Line

_____ Ft. from S. Line

_____ Ft. from E. Line

330 Ft. from W. Line

		o	

Morel Pool

Location _____

Rig up _____

Drilling and Remarks:

Ce & 3765
5' 3769
1000 casing
Depth 811875
Mat. 3000

303

RECORD

Cased _____ in., _____ ft.

Sand _____

Gas _____

Oil _____

Total Depth 3773

PRODUCTION

1st 24 hrs. Nat. _____

1st 24 hrs. after shot _____

Gas _____ Cu. Ft.

Dry Hole _____

Abandoned _____

Date

APR 12 1944 19 S. I. LEWIS Scout