

KANSAS

Graham

Section 23 Township 9 Range 21WWell No. 6 BalthazorCompany MagnoliaMorel
NORTH

					0		

WEST

EAST

SOUTH

2

KANSAS Graham

Sec. 23 Twp. 9 R. 21W ✓

Well No. #6 Balthazor Farm

Magnolia Company

Morel Pool


330' Ft. from N. Line

 Ft. from S. Line

 Ft. from E. Line

990' Ft. from W. Line

NE NW NE ..

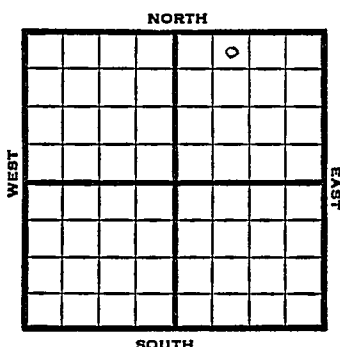

1949 Elev. 2264' REPORT

2/23 RUR

3/2 10" @ 218'
Drlg 1430'

3/8 Drlg 3290'

3/16 Lansing 3443'
Arb. 3767-69'
TD 3769'
6" @ 3767'

3/23 TD 3771'
Swb 5 bbls oil PH - 6 hrs.

3/30 Arb 3767'
6" @ 3767'
Pump 116 oil Pot.
Gr. 28.6°
TD 3771'

COMPLETED

Map No. _____ Sec. 23 Twp. 9 R. 21W

Well No. 6 Balthazor

Magnolia Company

FIRST REPORT

Contractor

NE NW NE

SECTION PLAT

330 Ft. from N. Line

_____ Ft. from S. Line

_____ Ft. from E. Line

990 Ft. from W. Line

		o	

Graham County

Location _____

Rig up _____

Drilling and Remarks:

R U R

RECORD

Cased _____ in., _____ ft.

Sand _____

Gas _____

Oil _____

* Total Depth _____

PRODUCTION

1st 24 hrs. Nat. _____

1st 24 hrs. after shot _____

Gas _____ Cu. Ft.

Dry Hole _____

Abandoned _____

Date

FEB 23 1949

19

S. J. LEWIS

Scout

Kansas

Map No. 65 Sec. 23 Twp. 9 R. 21WWell No. 6 BalthazorMagnolia

Company

COMPLETE

Contractor

NE NW NE

E12264
SECTION PLAT330 Ft. from N. Line Ft. from S. Line Ft. from E. Line990 Ft. from W. Line

		6	

Graham County

Location Rig up

Drilling and Remarks:


RECORD

Cased in., ft.Sand Gas Oil Total Depth 2721

PRODUCTION

1st 24 hrs. Nat. 1st 24 hrs. after shot Gas Cu. Ft.Dry Hole Abandoned

Date

MAR 30 1949

19

S. J. LEWIS

Scout