

KANSAS


Graham

Section 23 Township 9 Range 21W

Well No. #5 Balthazor

Company Magnolia

Morel Pool

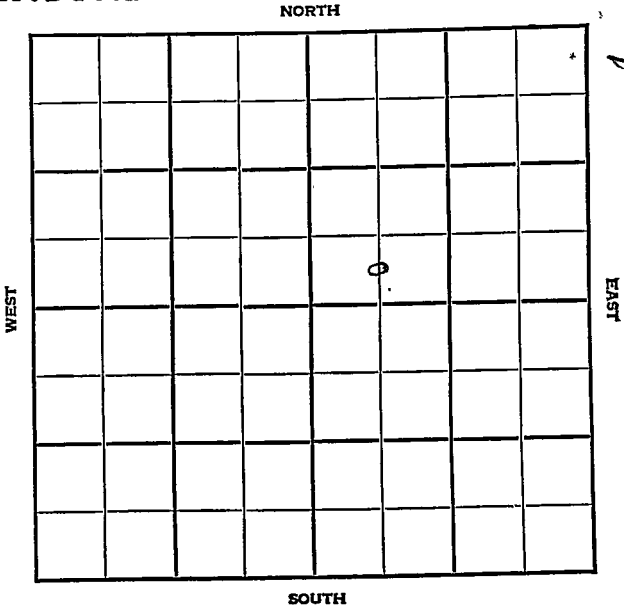

KANSAS

Graham

Sec. 23 Twp. 9 R. 21W

Well No. #5 Balthazor Farm
Magnolia Company

Morel Pool


_____ Ft. from N. Line

330' Ft. from S. Line

_____ Ft. from E. Line

660' Ft. from W. Line

C S L SW NE

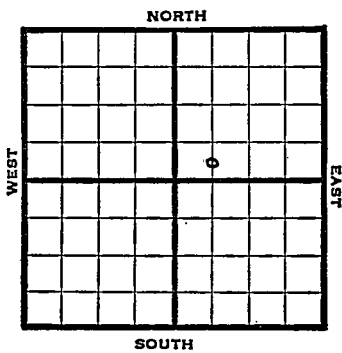

1948 Elev. 2278' REPORT

- 2/11 RUR
- 2/18 8" @ 212'
Drlg 550'
- 2/25 Drlg. 2950'
- 3/3 Lansing 3269'
Conglomerate 3752'
Simpson 3765'
Arbuckle 3777'
TD 3778'
5" @ 3778'
RUST
- 3/10 "
- 3/17 Arbuckle 3790' corrected
TD 3792'
2000' oil 2 hrs.
5" @ 3778'
- 3/24 Arb. 3790'
5" @ 3778'
Pump 182 Pot.
Gr. 27°
TD 3792'

COMPLETED

Map No. _____ Sec. 23 Twp. 9 R. 21W

Well No. 5 Balthazor

Magnolia Company

FIRST REPORT

Contractor

C S L SW NE

SECTION PLAT

_____ Ft. from N. Line

330 Ft. from S. Line

_____ Ft. from E. Line

660 Ft. from W. Line

		o	

Graham County

Location _____

Rig up _____

Drilling and Remarks:

R U R

RECORD

Cased _____ in., _____ ft.

Sand _____

Gas _____

Oil _____

Total Depth _____

PRODUCTION

1st 24 hrs. Nat. _____

1st 24 hrs. after shot _____

Gas _____ Cu. Ft.

Dry Hole _____

Abandoned _____

Date

FEB 11 1948 19

S. J. LEWIS Scout

Map No. 65 Sec. 23 Twp. 9 R. 21W

Well No. 5 Balthazor

Magnolia Company

COMPLETE

Contractor

C S L SW NE

E1, 2278

SECTION PLAT

 Ft. from N. Line

330 Ft. from S. Line

 Ft. from E. Line

660 Ft. from W. Line

Graham County

Location

Rig up

Drilling and Remarks:

Core 3790

5" @ 3778

Pump 182 ft

27-0-0

RECORD

Cased in., ft.

Sand

Gas

Oil ✓

Total Depth 3792

PRODUCTION

1st 24 hrs. Nat.

1st 24 hrs. after shot

Gas Cu. Ft.

Dry Hole

Abandoned

Date

MAR 24 1948 19

S. J. LEWIS Scout