

# KANSAS


Graham

FORM 51 5M PETROL

Section 23 Township 9 Range 21-W

Well No. #2 Hinman

Company Gulf

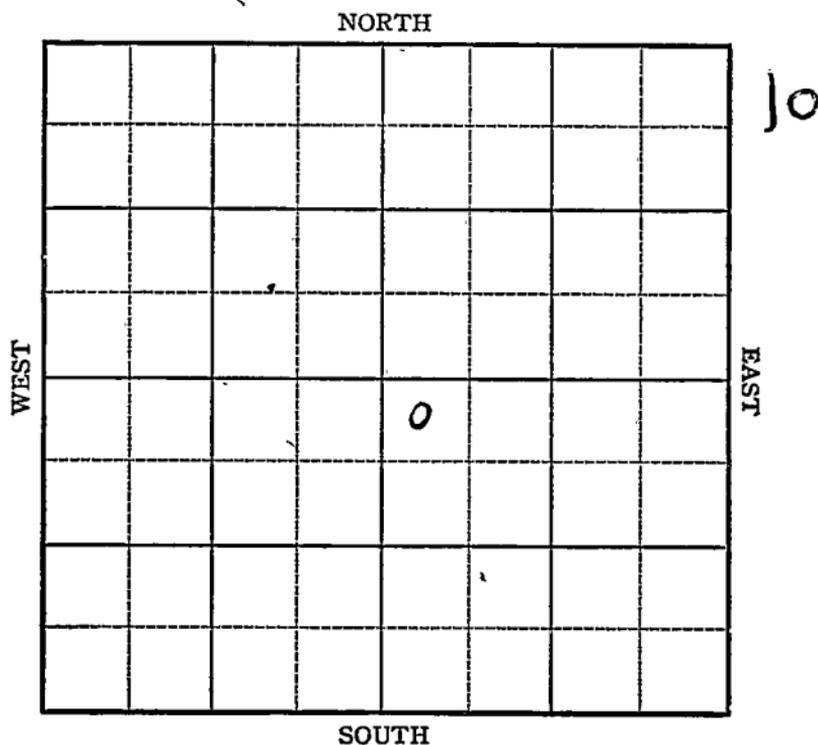

Sec. 23 Twp. 9 R. 21-W

Well No. #2 Hinman Farm.

Gulf Company


330 Ft. from N. Line

\_\_\_\_\_ Ft. from S. Line

\_\_\_\_\_ Ft. from E. Line

330 Ft. from W. Line

*Elev. 2285*

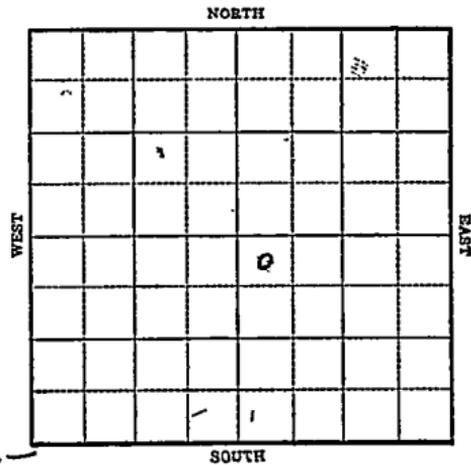

1943

R E P O R T

10/27 Location

11/3 Rotary

11/10 "

11/17 Drlg. 1650'

11/24 8" @ 1645

Anhy 1745

Drlg. 2985'

12/1 3507 fsg.

12/8 Lans 3494

Arb 3791-93 TD

5" @ 3792

RUST

12-15 TD 3802'

Shot 104 oil in 6 hrs.

2000 acid

12/22 5" @ 3792

Arb 3791

2000 acid

Sonicmeter Pot 7694

Max. 3000

Gravity 31

TD 3802'

COMPLETED

**KANSAS**

Map No. 63 Sec. 23 Twp. 9 R. 21W

Well No. 2 Hinman

Gulf Company

FIRST REPORT Contractor

NW SE.

**SECTION PLAT**

330 Ft. from N. Line

\_\_\_\_\_ Ft. from S. Line

\_\_\_\_\_ Ft. from E. Line

330 Ft. from W. Line

		o	

Wildcat

Location X

Rig up \_\_\_\_\_

Drilling and Remarks:

**RECORD**

Cased \_\_\_\_\_ in., \_\_\_\_\_ ft.

Sand \_\_\_\_\_

Gas \_\_\_\_\_

Oil \_\_\_\_\_

Total Depth \_\_\_\_\_

**PRODUCTION**

1st 24 hrs. Nat. \_\_\_\_\_

1st 24 hrs. after shot \_\_\_\_\_

Gas \_\_\_\_\_ Cu. Ft.

Dry Hole \_\_\_\_\_

Abandoned \_\_\_\_\_

Date

OCT 27 1943 19

S. J. LEWIS Scout

Map No. KANSAS 5 Sec. 23 Twp. 9 R. 21W

Well No. 2 Hinman

Gulf Company

**COMPLETED**

Contractor

NW SE

SECTION PLAT

330 Ft. from N. Line

\_\_\_\_\_ Ft. from S. Line

\_\_\_\_\_ Ft. from E. Line

330 Ft. from W. Line


Morel Pool

Location \_\_\_\_\_

Rig up \_\_\_\_\_

Drilling and Remarks:

*Core # 3791*

*5" @ 3792*

*20000 cu ft*

*Comineted by*

*7694*

*Map 3000*

*31/42*

RECORD

Cased \_\_\_\_\_ in., \_\_\_\_\_ ft.

Sand \_\_\_\_\_

Gas \_\_\_\_\_

Oil \_\_\_\_\_

Total Depth 3702

PRODUCTION

1st 24 hrs. Nat. \_\_\_\_\_

1st 24 hrs. after shot \_\_\_\_\_

Gas \_\_\_\_\_ Cu. Ft.

Dry Hole \_\_\_\_\_

Abandoned \_\_\_\_\_

Date

DEC 22 1943

19

S. J. LEWIS

Scout