

Sec. 33 Twp. 9 R. 21W


Well No. #5 Putman Investment Farm
Continental Company
Morel

 Ft. from N. Line

990 Ft. from S. Line

 Ft. from E. Line

990 Ft. from W. Line

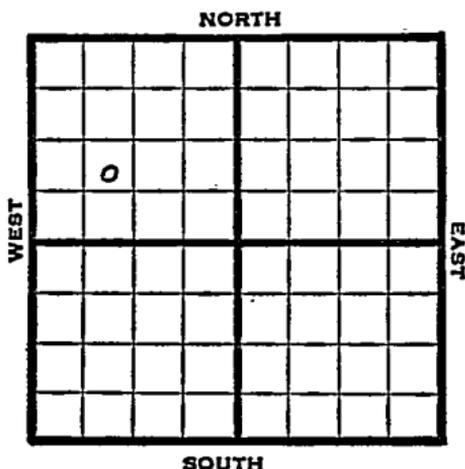

NE SW NW

1947

Elev. 2272' REPORT

7/23

Location

7/29

"

8/6

"

8/13

RUR

8/20

13" @ 257

Drlg. 2085'

8/27

Arbuckle 3741

TD 3760

5" @ 3742

RUST

9/3

TD 3762 swb

32 brls. oil PH 3 hrs

500 acid

9/10

Arbuckle 3741'

5" @ 3742

500 Acid

Depth Pot. 2822'

oil & 78 W

Gr. 270

Total Depth 3762'

COMPLETED

Kansas

Map No. _____ Sec. 33 Twp. 9 R. 21W

Well No. 5 Putman Investment

Continental Company

FIRST REPORT

Contractor

NE SW NW

SECTION PLAT

_____ Ft. from N. Line

990 Ft. from S. Line

_____ Ft. from E. Line

990 Ft. from W. Line

o			

Graham County

Location x

Rig up _____

Drilling and Remarks:

RECORD

Cased _____ in., _____ ft.

Sand _____

Gas _____

Oil _____

Total Depth _____

PRODUCTION

1st 24 hrs. Nat. _____

1st 24 hrs. after shot _____

Gas _____ Cu. Ft.

Dry Hole _____

Abandoned _____

Date

JUL 23 1947

19

S. J. LEWIS

Scout

