

KANSAS

Graham

Sec. 23 Twp. 9 R. 21W ✓

Well No. #3 W. Hinman Farm

Continental Company

Morel Pool


_____ Ft. from N. Line

330' Ft. from S. Line

990' Ft. from E. Line

_____ Ft. from W. Line

SW SE SW

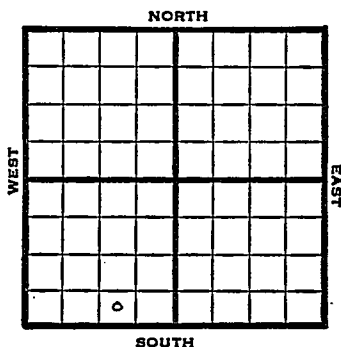

1949	Elev 2283'	REPORT
1/12	Location	
1/19	"	
1/26	Derrick	
2/2	"	
2/9	"	
2/16	10" @ 275'	
	Drlg 2170'	
2/23	Drlg 3675'	
3/2	Lansing 3478'	
	Arb. 3792-95'	
	TD 3795'	
	7" @ 3793'	
3/8	TD 3796'	
	500 acid	
3/16	Swb 39 bbls oil /, 1 W 12 hrs.	
3/23	Swb 2½ bbls oil & W PH - 8 hrs.	
3/30	500 acid	
	Pump 6 bbls oil 3 hrs.	
	TD 3803'	
4/6	"	
4/13	TD 3799'	
	Arb. 3792'	
	7" @ 3793'	
	Ab nd.	
	ABANDONED	

Map No. _____ Sec. 23 Twp. 9 R. 21W

Well No. 3 W. Hinman

Continental Company

FIRST REPORT Contractor

SW SE SW

SECTION PLAT

_____ Ft. from N. Line

330 Ft. from S. Line

990 Ft. from E. Line

_____ Ft. from W. Line

Graham County

Location X

Rig up _____

Drilling and Remarks:

RECORD

Cased _____ in., _____ ft.

Sand _____

Gas _____

Oil _____

Total Depth _____

PRODUCTION

1st 24 hrs. Nat. _____

1st 24 hrs. after shot _____

Gas _____ Cu. Ft.

Dry Hole _____

Abandoned _____

Date

JAN 1 2 1949 19

S. J. LEWIS Scout

