


Section 23 Township 9 Range 21W

Well No. #1 Lewis "B"

Company Cities Service Oil

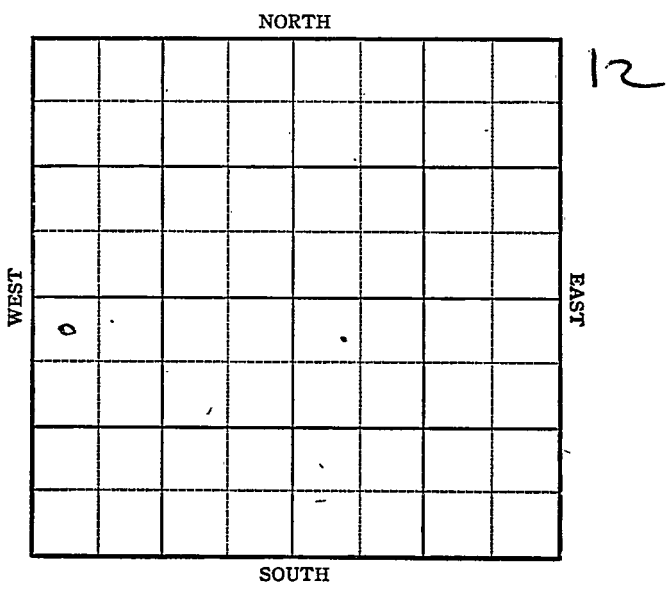

KANSAS

Graham

Sec. 23 Twp. 9 R. 21W

Well No. #1 Lewis "B" Farm

Cities Service Oil Company

Morel Pool

330 Ft. from N. Line


_____ Ft. from S. Line

_____ Ft. from E. Line

330 Ft. from W. Line

NW SW

Elev. 2315

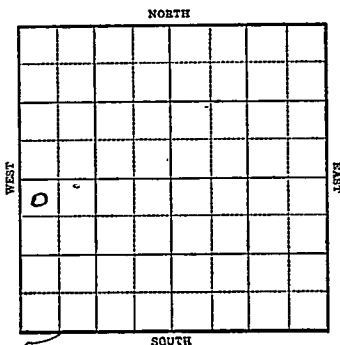

1944

R E P O R T

2/9	Location
2/15	"
2/23	"
3/1	"
3/8	Rotary
3/16	8" @ 175' Drilling 2365
3/22	Drlg. 3185'
3/29	SD 3185'
4/5	Drlg. 3450
4/12	Arb 3837-40 TD Sat 5" @ 3838 Rust
4/19	Lans 3508 TD 3843 1/8 bailer oil per hr.
4/26	500 acid Swb 10 oil per hr 10 hrs.
5/3	" " "
5/10	" "
5/17	" "

OVER

1944

5/31

Arb 3837

5" @ 3838

TD 3834

500 acid

Depth Pot 1785 oil & 30% water

Grav. 29.3

COMPLETED

Map No. KANSAS 6025 Sec. 23 Twp. 9 R. 21W

Well No. 1 Lewis "B"

Cities Service Oil Company

FIRST REPORT

Contractor

NW SW

330 Ft. from N. Line

_____ Ft. from S. Line

_____ Ft. from E. Line

330 Ft. from W. Line

SECTION PLAT

o			

Morel Pool

Location X

Rig up _____

Drilling and Remarks:

RECORD

Cased _____ in., _____ ft.

Sand _____

Gas _____

Oil _____

Total Depth _____

PRODUCTION

1st 24 hrs. Nat. _____

1st 24 hrs. after shot _____

Gas _____ Cu. Ft.

Dry Hole _____

Abandoned _____

Date

FEB 9 1944 19

S. J. LEWIS Scout

KANSAS

Pool Name Mor el Pool

Map No. 65 Sec. 23 Twp. 9 R. 21W

Well No. 1 Lewis "B"

Cities Service Oil Company

COMPLETED

Contractor

NW SW

SECTION PLAT

330 Ft. from N. Line

_____ Ft. from S. Line

_____ Ft. from E. Line

330 Ft. from W. Line

o			

Graham County

Location _____

Rig up _____

Drilling and Remarks:

Ce 8 3837
5" @ 3838
500 acid
Sept 15 @ 1785' oil
30% water
29³ sec

RECORD

Cased _____ in., _____ ft.

Sand _____

Gas _____

Oil _____

Total Depth 3848

PRODUCTION

1st 24 hrs. Nat. _____

1st 24 hrs. after shot _____

Gas _____ Cu. Ft.

Dry Hole _____

Abandoned _____

Date

MAY 3 1 1944 19

S. J. LEWIS Scout