


Section 23 Township 9 Range 21W
Well No. 6 Putman
Company Continental

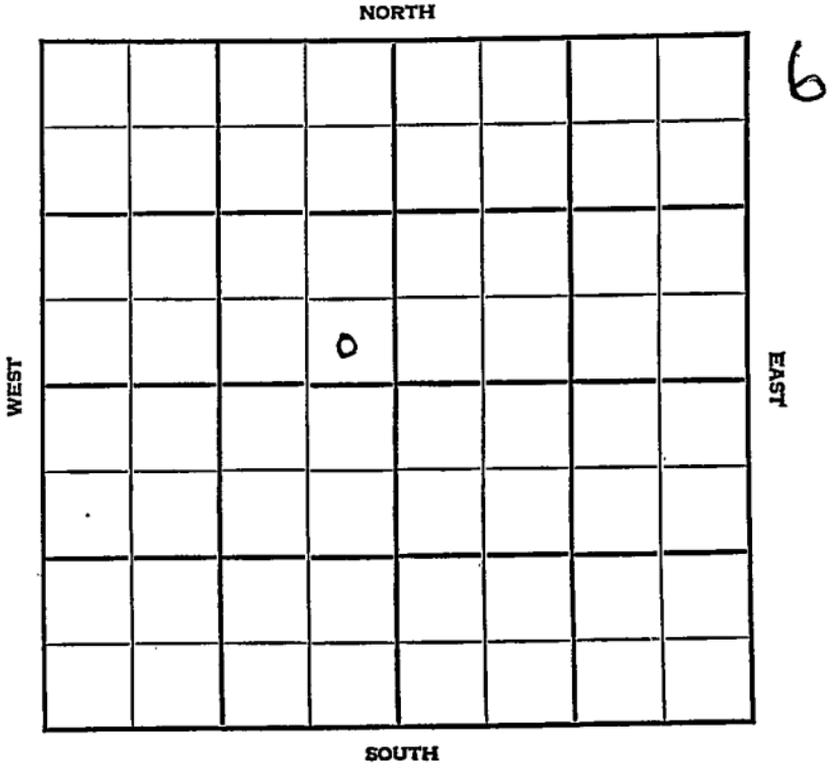

Sec. 23 Twp. 9 R. 21W

Well No. #6 Putman Farm _____

Continental Company


Adell

_____ Ft. from N. Line

330 Ft. from S. Line

330 Ft. from E. Line

_____ Ft. from W. Line

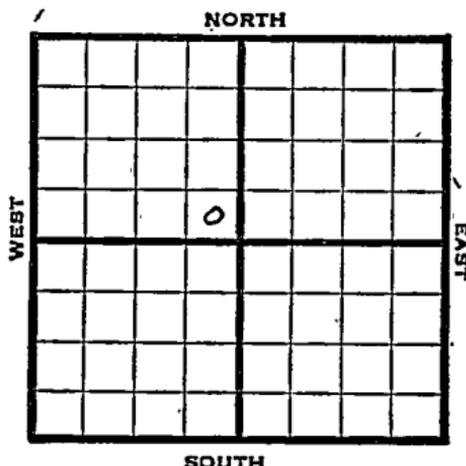

SE NW

1947

Elev. 2288' REPORT

12/23

Derrick

12/30

10" @ 378'
WOC

1948

1/7

Drlg. 2864'

1/14

Lansing 3228'
Arbuckle 3805'
TD 3809'
6" @ 3806'
RUST

1/21

"

1/26

"

2/4

Arb. 3805'
6" @ 3806'
Pump 195 oil / 46% W pot.
34.0 Gr.
TD 3809'
Comp.

COMPLETED

Map No. _____ Sec. 23 Twp. 9 R. 21W

Well No. 6 Putman

Continental Company

FIRST REPORT

SE NW Contractor

SECTION PLAT

_____ Ft. from N. Line

330 Ft. from S. Line

330 Ft. from E. Line

_____ Ft. from W. Line

Graham County

Location _____

Rig up _____

Drilling and Remarks:

Derrick

RECORD

Cased _____ in., _____ ft.

Sand _____

Gas _____

Oil _____

Total Depth _____

PRODUCTION

1st 24 hrs. Nat. _____

1st 24 hrs. after shot _____

Gas _____ Cu. Ft.

Dry Hole _____

Abandoned _____

Date

DEC 23 1947 19

S. J. LEWIS

Scout

Map No: 65 Sec. 23 Twp. 9 R. 21W

Well No. 6 Putman

Continental Company

COMPLETE Contractor

SE NW

E1,2288
SECTION PLAT

_____ Ft. from N. Line

330 Ft. from S. Line

330 Ft. from E. Line

_____ Ft. from W. Line

Graham County

Location _____

Rig up _____

Drilling and Remarks:

Cur 3805

6" @ 3806

Pump 190 oil +

#6 to W. Pad.

340 g

RECORD

Cased _____ in., _____ ft.

Sand _____

Gas _____

Oil

Total Depth 3809

PRODUCTION

1st 24 hrs. Nat. _____

1st 24 hrs. after shot _____

Gas _____ Cu. Ft.

Dry Hole _____

Abandoned _____

Date

FEB 4 1948 19

S. J. LEWIS Scout