

KANSAS


Graham

FORM 51 5M PETROL

Section 23 Township 9 Range 21W

Well No. #3 Putman Inves. "A"

Company Continental

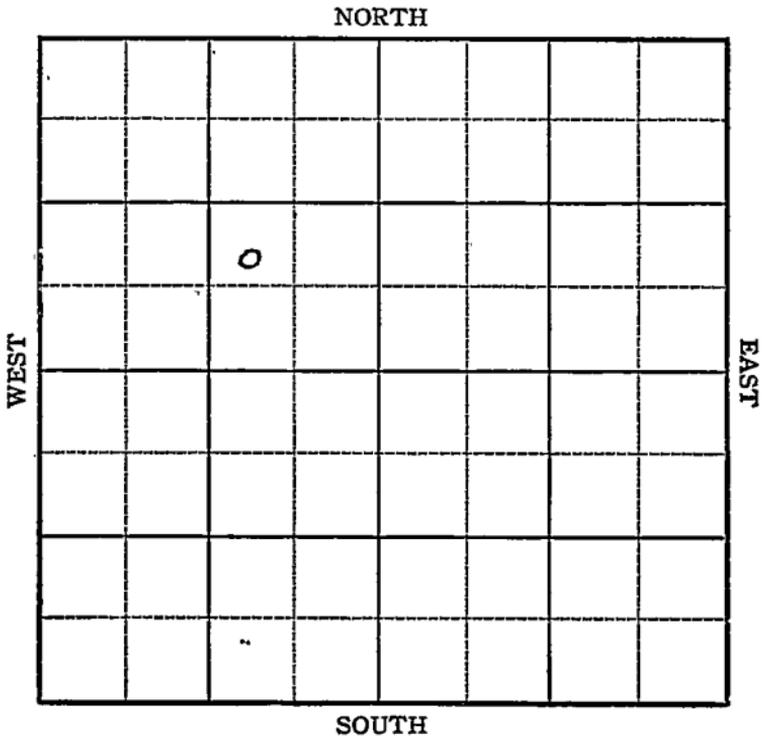


Sec. 23 Twp. 9 R. 21W

Well No. #3 Putman Inves "A" Farm

Continental Company

Morel

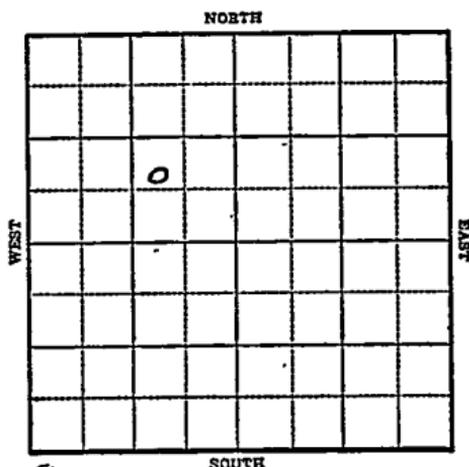

 Ft. from N. Line

890 Ft. from S. Line

990 Ft. from E. Line

 Ft. from W. Line

NW SE NW

Elev. 2298.

R E P O R T

1944

- 2/16 Location
- 2/23 Derrick
- 3/1 Drlg. 780'
- 3/8 Drlg. 1880'
- 3/16 Drlg. 2775
- 3/2 2 Drlg. 3407
10" @ 241
- 3/29 Arb 3809-16 TD
6" @ 3810
Rust
- 4/5 " .
- 4/12 "
- 4/19 Lans 3490
TD 3876
2900' oil
- 4/26 Swb 20 oil per hr 3 hrs.
- 5/2 6" @ 3810
Arb 3809
Td3816
Pump 602 Pot.
Gravity 30

COMPLETED

KANSAS

Map No. 65 Sec. 23 Twp. 9 R. 21WWell No. 3 Putman Inves. "A"Continental Company

FIRST REPORT

Contractor

NW SE NW

SECTION PLAT

 Ft. from N. Line

890

 Ft. from S. Line

990

 Ft. from E. Line Ft. from W. Line

	o		

Morel Pool

Location **X**Rig up Drilling and Remarks:

RECORD

Cased in., ft.Sand Gas Oil Total Depth

PRODUCTION

1st 24 hrs. Nat. 1st 24 hrs. after shot Gas Cu. Ft.Dry Hole Abandoned

Date

FEB 16 1944 19

S. J. LEWIS Scout

