


Section 23 Township 9 Range 21W

Well No. 7 Putman "A"

Company Continental

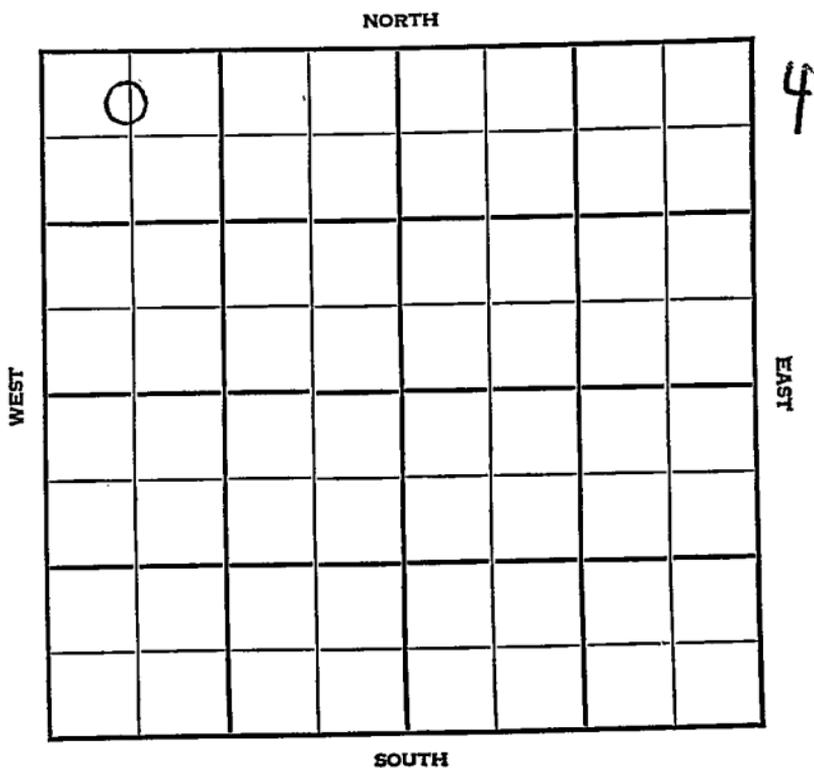

KANSAS

Sec. 23 Twp. 9 R. 21W

#7 Putman "A"

Well No. _____ Farm _____

Continental _____ Company

Morel Pool


330' Ft. from N. Line

_____ Ft. from S. Line

_____ Ft. from E. Line

660' Ft. from W. Line

C N L NW NW

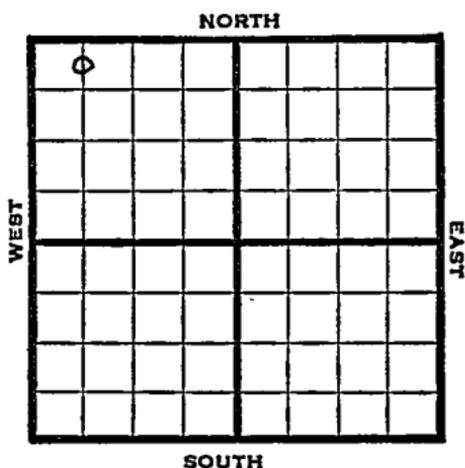

1948

Eli 2281'

REPORT

7/28

Derrick

8/4

10" @ 395'
Drlg. 2578'

8/11

Drlg 3752'

8/18

Arbuckle 3840'
TD 3847'
Aband.

ABANDONED

Graham County Kansas State

Map No. _____ Sec. 23 Twp. 9 R. 21W

Well No. 7 Putman "A"

Continental Company

FIRST REPORT

Contractor

C N L NW NW

SECTION PLAT

⊕					

330 Ft. from N. Line

_____ Ft. from S. Line

_____ Ft. from E. Line

660 Ft. from W. Line

Morel Pool

Remarks:

\ **Derrick**

Date
JUL 28 1948

Scout
S. J. LEWIS

Graham County Kansas State

Map No. 65 Sec. 23 Twp. 9 R. 21W

Well No. 7 Putman "A"

Continental Company

ABANDONED

Contractor

C N L NW NW

E 1,2287
SECTION PLAT

330 Ft. from N. Line

_____ Ft. from S. Line

_____ Ft. from E. Line

660 Ft. from W. Line

φ							

Morel Pool

Remarks:

CE 83840

7173847

Date
AUG 18 1948

Scout S. J. LEWIS