

KANSAS


Graham County

FORM 51 5M BRIX

Section 23 Township 9 Range 21W

Well No. #4 Putman Investments "B"

Company Continental Co.

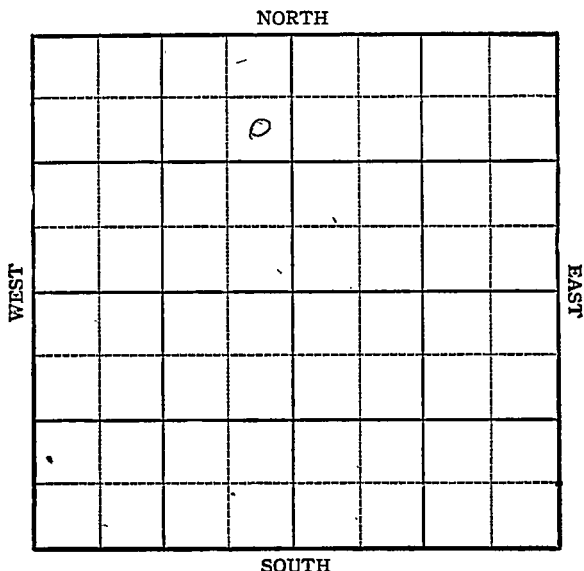

KANSAS

Graham

Sec. 23 Twp. 9 R. 21W

Well No. #4 Putman Investments "B" Farm
Continental Company


Morel

990 Ft. from N. Line

Ft. from S. Line

330 Ft. from E. Line

Ft. from W. Line

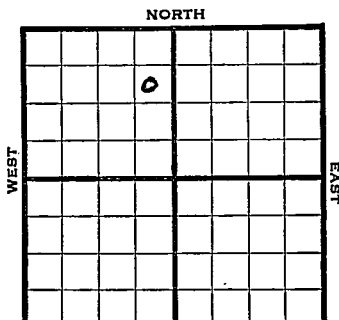

SE NE NW

Elev. 2281

1944

REPORT

9/6

Derrick.

9/13

"

9/21

RUR

9/28

10" @ 242 Drlg. 2565

10/4

Drlg. 3767

10/11

Lans 3464'

Arb. 3805


TD 3872'

ABANDONED

Pool Name Mor elMap No. 65 **KANSAS** Sec. 23 Twp. 9 R. 21 WWell No. 4 Putman Investments "B"Continental CompanyFIRST REPORT Contractor

SE NE NW

SECTION PLAT

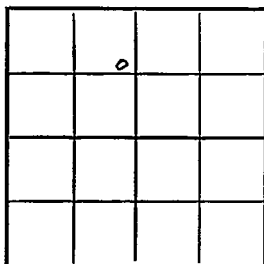990 Ft. from N. Line Ft. from S. Line330 Ft. from E. Line Ft. from W. LineGraham CountyLocation Rig up

Drilling and Remarks:

Derrick

RECORD

Cased in., ft.Sand Gas Oil Total Depth

PRODUCTION


1st 24 hrs. Nat. 1st 24 hrs. after shot Gas Cu. Ft.Dry Hole Abandoned

Date

SEP 6 1944 19S. J. LEWIS Scout

Pool Name MorelMap No. 65 Sec. 23 Twp. 9 R. 21WWell No. 4 Putman Investment "B"Continental CompanyABANDONED ContractorSE NE NW

SECTION PLAT

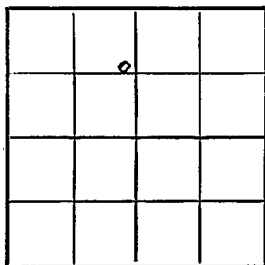990 Ft. from N. Line Ft. from S. Line330 Ft. from E. Line Ft. from W. LineGraham CountyLocation Rig up

Drilling and Remarks:

Louis 3464Ar 3805

RECORD

Cased in., ft.Sand Gas Oil Total Depth 3872

PRODUCTION

1st 24 hrs. Nat. 1st 24 hrs. after shot Gas Cu. Ft.Dry Hole Abandoned

Date

OCT 1 1 1944 19 S. J. LEWIS Scout