


Graham KANSAS

DX 78-1

Section 23 Township 9 Range 22W

Well No. 21 Holzauer "A"

Company Cities Service

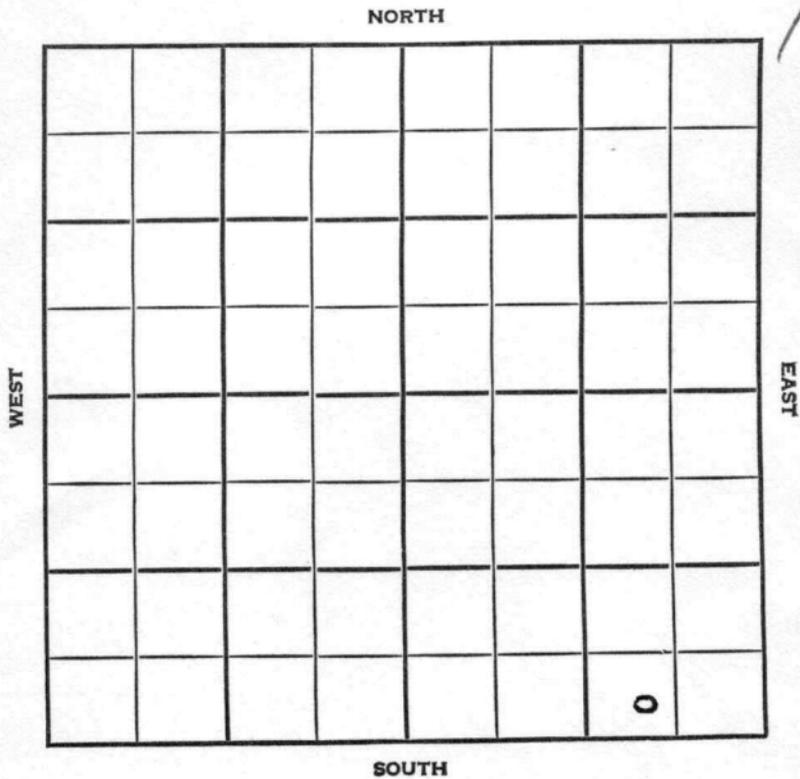

Graham KANSAS ✓


SEC. 23	TWP. 9	R. 22W
---------	--------	--------

WELL NO. #2 Holzhauser "A" FARM

COMPANY
Cities Service

CONTRACTOR
Lohman & Johnson-Contr.

_____ Ft. from N. Line
330 _____ Ft. from S. Line
855 _____ Ft. from E. Line
_____ Ft. from W. Line

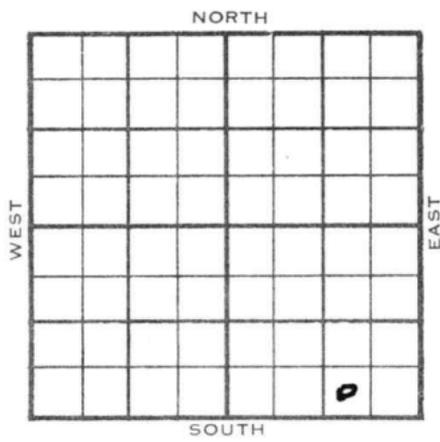

SW SE SE

1954	ELEVATION	REPORT
	2343'	

6/15 Loc.

6/23 8" @ 240'
Anhy 1826', Heeb 3518'
Drlg. 3535'

7/28 Spud 6-16-54 Oil well TD 3785
8" @ 240 Anhy 1826 Heeb 3518
Dodge 3538 Lans 3554
DST 3555-74 open 1 hr rec 10' mud
30' SOCM & wtr. 600#
DST 3594-3621, open 1 hr rec 2' oil
30' SOCM & SW. 150' SW. 670#
DST 3688-3700, open 1/2 hr, rec 32'
mud, 400#
DST 3729-40 open 1 hr rec 11' mud
900# B KC 3774 TD 3785'
5" @ 3785 CO to 3763 33/3728-37
23/3693-99 1500 A P/88 BW SP 3631
39/3591-3601 23/3554-62 2000 A
P/21 BO 13 1/4 BW P/14 BO 45 BW 10 hr.
Comp. 27 BOPD 143 BW

COMPLETED

Kansas

Map No. _____ Sec. 23 Twp. 9 R. 22W

Well No. 2 Holzhauser "A"

Cities Service

Company

CORRECTION

Contractor

SW SE SE

SECTION PLAT

_____ Ft. from N. Line

330 Ft. from S. Line

855 Ft. from E. Line

_____ Ft. from W. Line

			0

Graham County

Location _____

Rig up _____

Drilling and Remarks:

Reported

#1 Holzhauser

RECORD

Cased _____ in., _____ ft.

Sand _____

Gas _____

Oil _____

Total Depth _____

PRODUCTION

1st 24 hrs. Nat. _____

1st 24 hrs. after shot _____

Gas _____ Cu. Ft.

Dry Hole _____

Abandoned _____

Date

JUN 30 1954 19

J. G. McGEHEE

Scout

