


Section 23 Township 9 Range 22-W

Well No. #2 Suttor-Lewis

Company C & G Drlg. etal

14

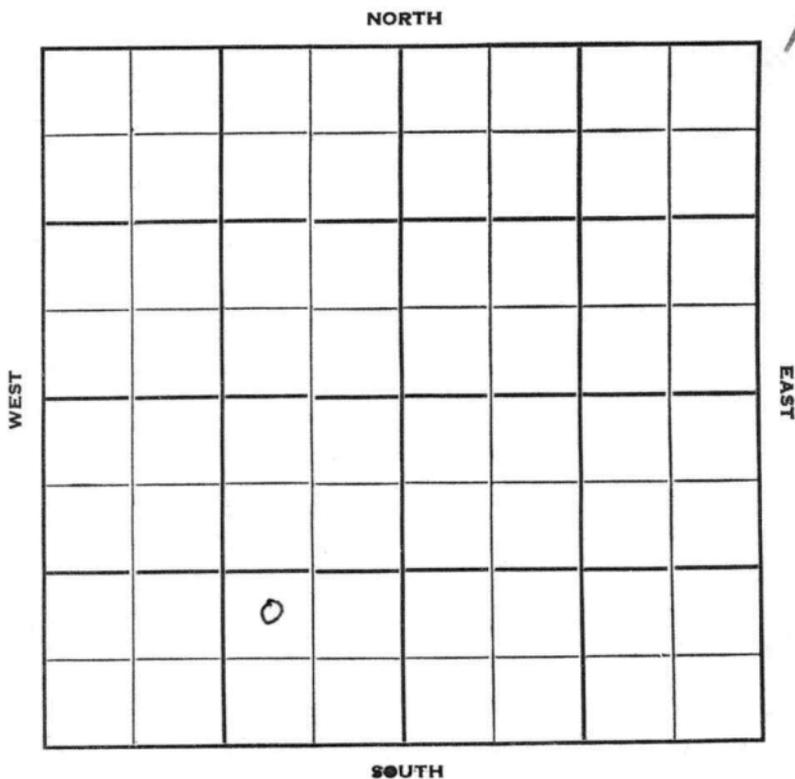

Graham

KANSAS ✓

Sec. 23 Twp. 9 R. 22W

Well No. #2 Suttor - Lewis Farm

C & G Drlg. et al Company

C & G Drlg. - Contr. Contractor

Iron Glad Pool


_____ Ft. from N. Line

990' Ft. from S. Line

990' Ft. from E. Line

_____ Ft. from W. Line

NW SE SW

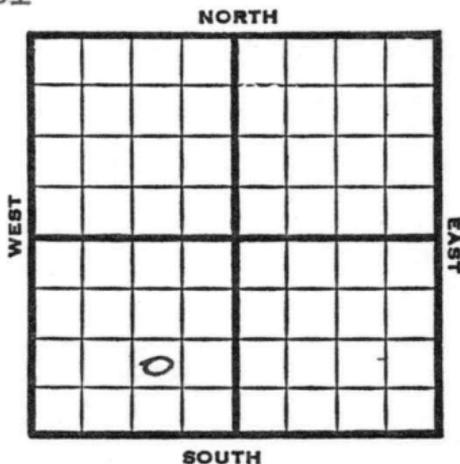

1951

Elev. 2341' REPORT

1/10

Spud 1-4-51
8" @ 229
Anhy 1820-58
Drlg. 3200

1/17

Spud 1-4-51
D&A TD 3920
8" @ 229' Anhy 1820-58
Top. 3334' Heeb. 3517
Toronto 3539 KC 3561
DST 3595-3607 opn 1 hr
Rec. 188' wtr
DST 3752-60 opn 1/2 hr Rec. 6' mud
BKC 3785 Cong. 3878 Arb. 3907-20TD
D&A

ABANDONED

