FORM 51 25M 3-49 PETROL


KANSAS

Graham

Section 23 Township 9 Range 22-W

Well No. #1 Zvalaneh

Company C & G Drlg & Hanson

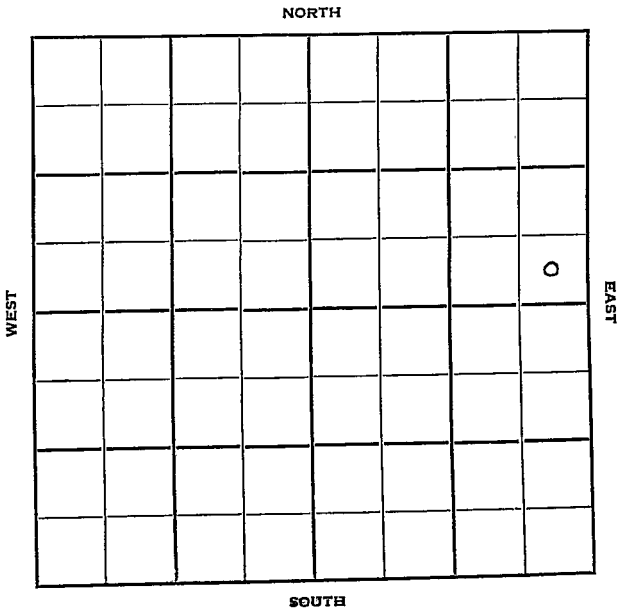

FORM 252-B
10M 9-49 PETROL

Graham KANSAS

Sec. 23 Twp. 9 R. 22W ✓

Well No. #1 Zvalaneh Farm

C & G Drlg. & Hanson Company

C & G Drlg. Contractor


Ft. from N. Line

330' Ft. from S. Line

330' Ft. from E. Line

Ft. from W. Line

SE SE NE

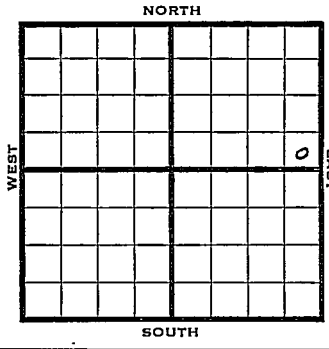

1950

Elev 2316

REPORT

6/28
7/12

Location
8" @ 245
Anhy 1835
Heeb 3530
Lans KC 3569
Cong 3895
TD 3995
D&A

Topeka 3341
Toronto 3550
B KC 3790
Arb 3962

ABANDONED

Form 26 200 Bks. 11-49 Petrol Kansas

Map No. _____ Sec. 23 Twp. 9 R. 22W


Well No. 1 Zvalaneh

C & G Drlg. & Hanson Company

C & G Drlg. Contractor

SE SE NE

SECTION PLAT

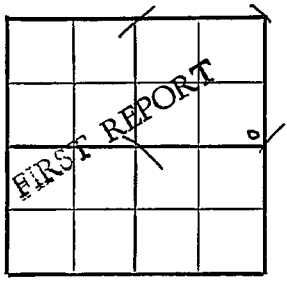

_____ Ft. from N. Line

330 Ft. from S. Line

330 Ft. from E. Line

_____ Ft. from W. Line

Graham County

Location x

Rig up _____

Drilling and Remarks:

RECORD

Cased _____ in., _____ ft.

Sand _____

Gas _____

Oil _____

Total Depth _____

PRODUCTION

1st 24 hrs. Nat. _____

1st 24 hrs. after shot _____

Gas _____ Cu. Ft.

Dry Hole _____

Abandoned _____

Date

JUN 2 8 1950 19 J. E. TYRA Scout

Form 26 200 Bks. 11-49 Petrol

Kansas

Map No. _____ Sec. 23 Twp. 9 R. 22W


Well No. 1 Zvalaneh

C & G Drlg. & Hanson Company

Contractor

S~ SE NE El. 2316

SECTION PLAT

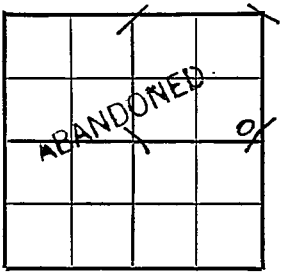

_____ Ft. from N. Line

330 Ft. from S. Line

330 Ft. from E. Line

_____ Ft. from W. Line

Graham County

Location _____

Rig up _____

Drilling and Remarks:

8" @ 245
Anhy 1835
Topeka 3341
Heeb. 3530
Toronto 3550
Lans. KC 3569
B KC 3790

RECORD

Cased _____ in., _____ ft.

Sand _____

Gas _____

Oil _____

Total Depth 3995

PRODUCTION

1st 24 hrs. Nat. _____

1st 24 hrs. after shot _____

Gas _____ Cu. Ft.

Dry Hole _____

Abandoned _____

Date

JUL 12 1950 19 J. E. TYRA Scout

Cong. 3895

Arb. 3962

TD 3995

D & A