

SEC. 23	TWP. 9	R. 23W
------------	-----------	-----------

WELL NO. #1 Denning FARM

COMPANY E.K. Carey


CONTRACTOR Co. Tools.
Wildcat.

_____ Ft. from N. Line

330 _____ Ft. from S. Line

_____ Ft. from E. Line

330 _____ Ft. from W. Line

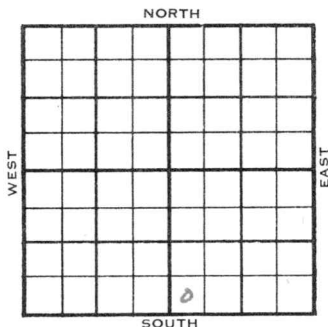

SW SW SE
Continental - AC.

	ELEVATION	REPORT
1955	2400'	

2/23 Spud 2-21-55
8" @ 192'

WOC

3/16 Spud 2-21-55 D&A TD 4227
8" @ 192, Heeb 3674, Tor 3699,
Lans 3711, B KC 3931, Cong 4128,
Arb 4215, DST 3702-65, open 1
hr., Rec 90' SW 1120# TD 4227
D&A

ABANDONED

