

18-9-23W

STATE CORPORATION COMMISSION OF KANSAS
OIL & GAS CONSERVATION DIVISION
WELL COMPLETION OR RECOMPLETION FORM
ACO-1 WELL HISTORY
DESCRIPTION OF WELL AND LEASE

Operator: License # 5135
Name John O. Farmer, Inc.
Address P.O. Box 352
Russell, KS 67665
City/State/Zip

Purchaser

Operator Contact Person Margaret A. Schulte
Phone (913) 483-3144

Contractor: License # 5135
Name John O. Farmer, Inc.

Wellsite Geologist
Phone

Designate Type of Completion
 New Well Re-Entry Workover
 Oil SWD Temp Abd
 Gas Inj Delayed Comp.
 Dry Other (Core, Water Supply etc.)

If OWO: old well info as follows:
Operator
Well Name
Comp. Date Old Total Depth

WELL HISTORY

Drilling Method:
 Mud Rotary Air Rotary Cable

12-16-86 12-18-86 12-18-86
Spud Date Date Reached TD Completion Date

1800' Total Depth
PBTD

Amount of Surface Pipe Set and Cemented at 134 feet
Multiple Stage Cementing Collar Used? Yes No
If yes, show depth set feet

If alternate 2 completion, cement circulated from 134 feet depth to surface 100 SX cmt
Cement Company Name Allied Cementing Co., Inc.
Invoice # 47828

API NO. 15-065-22,342

County Graham

C SE NW 18 9S 23 East
Sec. Twp. Rge. X West

3300 Ft North from Southeast Corner of Section
3300 Ft West from Southeast Corner of Section


(Note: Locate well in section plat below)

Lease Name Albertson Water Well # 2

Field Name Ernst Northwest

Producing Formation (Estimated)
Elevation: Ground 2335' KB 2340'

Section Plat

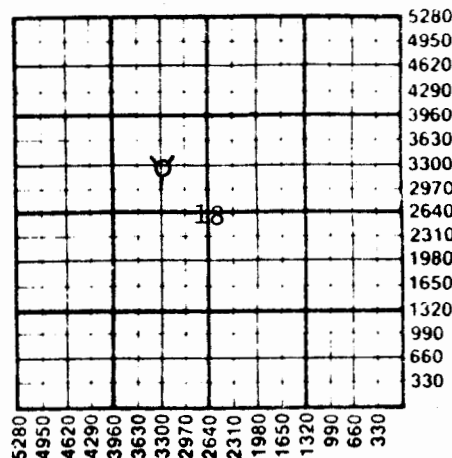

WATER SUPPLY INFORMATION

Disposition of Produced Water: Disposal
Docket # Repressuring

Questions on this portion of the ACO-1 call:
Water Resources Board (913) 296-3717

Source of Water:
Division of Water Resources Permit #

Groundwater 1320 Ft North from Southeast Corner
3300 Ft West from Southeast Corner of
Sec 18 Twp 9S Rge 23 East X West

Surface Water Ft North from Southeast Corner
(Stream, pond etc) Ft West from Southeast Corner
Sec Twp Rge East West

Other (explain)
(purchased from city, R.W.D. #)

INSTRUCTIONS: This form shall be completed in triplicate and filed with the Kansas Corporation Commission, 200 Colorado Derby Building, Wichita, Kansas 67202, within 120 days of the spud date of any well. Rule 82-3-130, 82-3-107 and 82-3-106 apply. Information on side two of this form will be held confidential for a period of 12 months if requested in writing and submitted with the form. See rule 82-3-107 for confidentiality in excess of 12 months. One copy of all wireline logs and drillers time log shall be attached with this form. Submit CP-4 form with all plugged wells. Submit CP-111 form with all temporarily abandoned wells.

Water

Operator Name John O. Farmer, Inc. Lease Name Albertson Well # 2

Sec 18 Twp 9S Rge 23 East West County Graham

WELL LOG

INSTRUCTIONS: Show important tops and base of formations penetrated. Detail all cores. Report all drill stem tests giving interval tested, time tool open and closed, flowing and shut-in pressures, whether shut-in pressure reached static level, hydrostatic pressures, bottom hole temperature, fluid recovery, and flow rates if gas to surface during test. Attach extra sheet if more space is needed. Attach copy of log.

Drill Stem Tests Taken [] Yes [X] No
Samples Sent to Geological Survey [] Yes [X] No
Cores Taken [] Yes [X] No

Formation Description [] Log [] Sample

Table with 3 columns: Formation Name, Top, Bottom. Rows: Shale (0, 425), Shale & Sand (425, 1540), Sand (1540, 1742), Red Bed (1742, 1800)

Name Top Bottom

Table with 6 columns: Oil, Gas, Water, Gas-Oil Ratio, Gravity. Row: Estimated Production Per 24 Hours

METHOD OF COMPLETION

Production Interval

Disposition of gas: [] Vented [] Sold [] Used on Lease [] Open Hole [X] Perforation [] Other (Specify) 1498-1508' 1512-1516' [] Dually Completed

CASING RECORD [] New [] Used

Report all strings set-conductor, surface, intermediate, production, etc.

Table with 8 columns: Purpose of String, Size Hole Drilled, Size Casing Set (In O.D.), Weight Lbs/Ft., Setting Depth, Type of Cement, #Sacks Used, Type and Percent Additives

PERFORATION RECORD

Acid, Fracture, Shot, Cement Squeeze Record

Table with 4 columns: Shots Per Foot, Specify Footage of Each Interval Perforated, (Amount and Kind of Material Used), Depth

TUBING RECORD Size 2-7/8" Set At 1409' Packer at -- Liner Run [] Yes [X] No

Date of First Production Producing Method [] Flowing [X] Pumping [] Gas Lift [] Other (explain)