

KANSAS DRILLERS LOG

S. 18 T. 9S R. 23W ^E/_W

API No. 15 — County _____ Number _____

Loc. SE NE SW

County Graham

Operator
John O. Farmer, Inc.

Address
Box 352 Russell, Kansas 67665


Well No. #1 Lease Name ALBERTSON 'B'

Footage Location
990 feet from (N) (S) line 330 feet from (E) (W) line

Principal Contractor John O. Farmer, Inc. Geologist Sam Farmer

Spud Date 6-5-78 Total Depth 3990' P.B.T.D.

Date Completed 6-14-78 Oil Purchaser Mobil

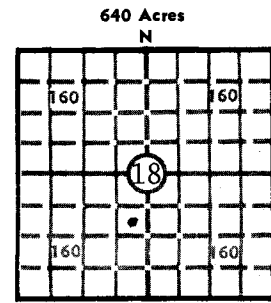

Locate well correctly
Elev.: Gr. 2407'

DF 2410' KB 2412'

CASING RECORD

Report of all strings set — surface, intermediate, production, etc.

Purpose of string	Size hole drilled	Size casing set (in O.D.)	Weight lbs/ft.	Setting depth	Type cement	Sacks	Type and percent additives
Surface	12¼	8-5/8	26	202'	Common	160	
Production	7-7/8	4½	10½	3989'	Common	150	
		DV Tool	2075'		Common	350	

LINER RECORD

PERFORATION RECORD

Top, ft.	Bottom, ft.	Sacks cement	Shots per ft.	Size & type	Depth interval
			4	JB	3890' - 3894'

Size	Setting depth	Packer set at
2"	3885'	3902'

ACID, FRACTURE, SHOT, CEMENT SQUEEZE RECORD

Amount and kind of material used	Depth interval treated
2000 Gal. 15% HCL	3890' - 3894'

INITIAL PRODUCTION

Date of first production 6-18-78	Producing method (flowing, pumping, gas lift, etc.) Pumping
RATE OF PRODUCTION PER 24 HOURS	Oil 80 bbls. Gas -0- MCF Water Trace bbls. Gas-oil ratio -0- CFPB
Disposition of gas (vented, used on lease or sold)	Producing interval (s) Lansing

INSTRUCTIONS: As provided in KCC Rule 82-2-125, within 90 days after completion of a well, one completed copy of this Drillers Log shall be transmitted to the State Geological Survey of Kansas, 4150 Monroe Street, Wichita, Kansas 67209. Copies of this form are available from the Conservation Division, State Corporation Commission, 3830 So. Meridian (P.O. Box 17027), Wichita, Kansas 66217. Phone AC 316-522-2206. If confidential custody is desired, please note Rule 82-2-125. Drillers Logs will be on open file in the Oil and Gas Division, State Geological Survey of Kansas, Lawrence, Kansas 66044.

Operator
John O. Farmer, Inc.

DESIGNATE TYPE OF COMP.: OIL, GAS, DRY HOLE, SWDW, ETC.:

Well No. #1 Lease Name ALBERTSON 'B'

S 18 T 9S R 23W E W Oil

WELL LOG

Show all important zones of porosity and contents thereof; cored intervals, and all drill-stem tests, including depth interval tested, cushion used, time tool open, flowing and shut-in pressures, and recoveries.

SHOW GEOLOGICAL MARKERS, LOGS RUN, OR OTHER DESCRIPTIVE INFORMATION.

FORMATION DESCRIPTION, CONTENTS, ETC.	TOP	BOTTOM	NAME	DEPTH
Sample Tops:			Log Tops:	
Clay & Post Rock	-0-	80	Anhydrite	2048 (+364)
Blue Shale	80	207	Heebner	3699 (-1287)
Shale & Sand	207	1589	Toronto	3726 (-1314)
Sand	1589	1790	Lansing	3742 (-1330)
Red Bed	1790	2049	Log TD	3989 (-1577)
Anhydrite	2049	2084	Rotary TD	3990
Shale & Shells	2084	2760		
Shale & Lime	2760	3680		
Lime	3680	3990		
<p>DST. #1 3760' to 3825' Tool open 30-45-60-60; strong blow Rec: 191' slightly oil & gas cut watery mud; 455' slightly oil & gas muddy water; 495' gassey water IFP: 74-338 FFP: 380-559 BHP: 802-802</p> <p>DST. #2 3880' to 3901' Tool open 60-60-60-75; fair to good blow Rec: 260' gas; 110' oil cut mud (30% oil) IFP: 32-42 FFP: 63-63 BHP: 359-359</p> <p>DST. #3 3915' to 3940' Tool open 30-45-60-60; Good blow Rec: 525' gas; 216' gassey heavy oil cut mud IFP: 53-74 FFP: 95-116 BHP: 253-253</p>				

USE ADDITIONAL SHEETS, IF NECESSARY, TO COMPLETE WELL RECORD.

Date Received	<i>John O. Farmer</i>
	Signature President
	Title 7-14-78 Date