


Section 24 Township 9 Range 19W

Well No. 3 Jelinek

Company Derby Oil

13

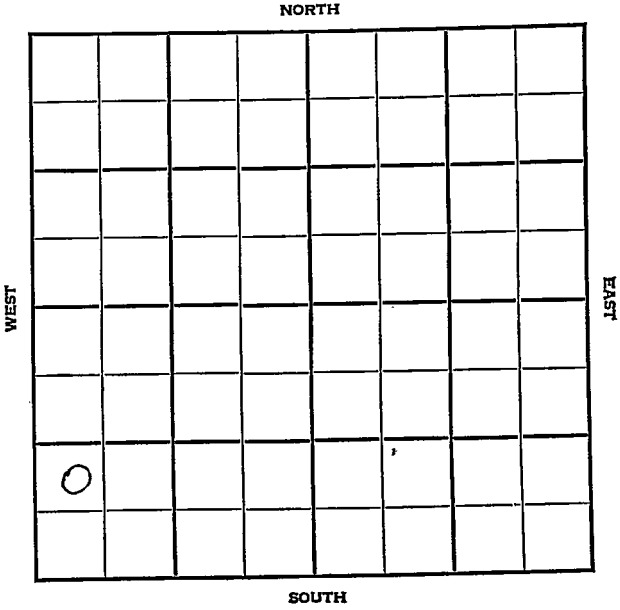

KANSAS

Rocks



Sec. 24 Twp. 9 R. 19W

Well No. #3 Jelinek Farm

Derby Oil Company

Jelinek Pool

NORTH


 Ft. from N. Line

990' Ft. from S. Line

 Ft. from E. Line

330' Ft. from W. Line

NW SW SW

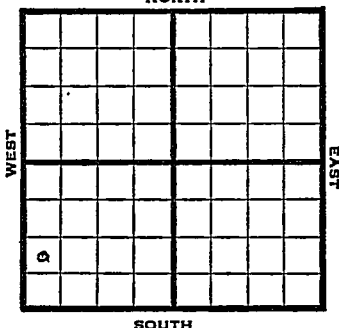

1948

Elev. 2153' REPORT

- 7/28 Location
- 8/4 8" @ 263'
Drlg. 965'
- 8/11 Drlg 3343'
- 8/18 Lansing 3331'
Arbuckle 3567'
TD 3571
5" @ 3568'
- 8/25 TD 3578'
Swb 1½ oil
PH 500 acid
- 9/1 TD 3589'
1000 acid swab 75 W & 3½ bbls oil
3 hrs
PB 3583'
- 9/8 "
- 9/14 "
- 9/21 "
- 9/29 "
- 10/6 Arbuckle 3567'
5" @ 3567'
Pump 126 oil & 7% W Pot.
Gr. 28°
TD 3589'

COMPLETED

