


Section 24 Township 9 Range 19W

Well No. 5 Jelinek

Company Derby et al

Jelinek Pool  
NORTH

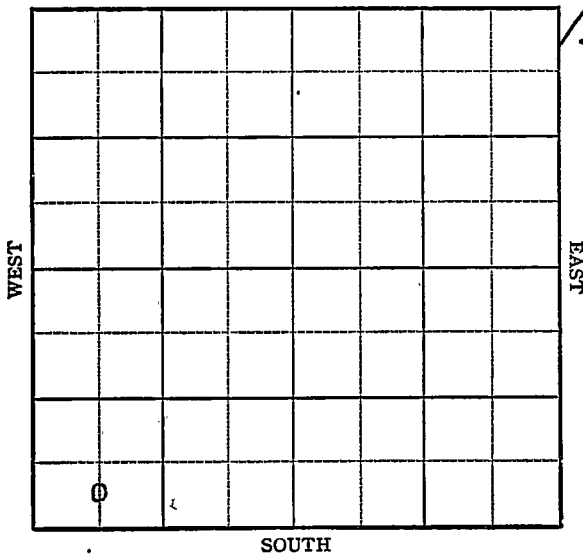

13


KANSAS Rocks

Sec. 24 Twp. 9 R. 19W ✓

Well No. #5 Jelinek Farm

Derby et al Company

Jelinek Pool

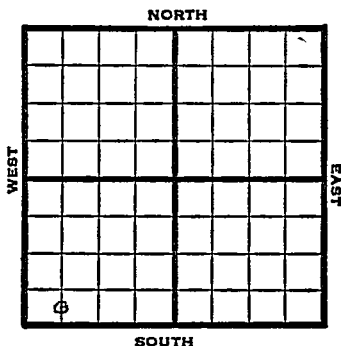

\_\_\_\_\_ Ft. from N. Line

330'

\_\_\_\_\_ Ft. from S. Line

\_\_\_\_\_ Ft. from E. Line

660'

\_\_\_\_\_ Ft. from W. Line

C S L SW SW

1949

Elev 2171' REPORT

1/12

Location

1/19

"

1/26

"

2/2

"

2/9

Location

2/16

"

2/23

"

3/2

"

3/8

"

3/16

8" @ 286'  
D rlg 3180'

3/23

Lensing 3347'  
Arbuckle 3586'  
TD 3641'  
4" @ 3640'

3/30

15 shots 3600-05 - 50 acid  
Plug 3599'  
11 shots 3692-95  
Swb 28 bbls oil / 28 W 2 hrs.

4/6

Squeeze  
24 shots 3591-96  
800 acid  
Swb 1½ bbls oil PH 6 hrs.

4/12

"

4/20

"

4/27

"

OVER

1949

5/4

TD 3641'

Lans. 2347'

Arb. 3586'

4" @ 3640'

Perf 1000 acid

Pump 58 Oil Pot

29<sup>0</sup> Gr.

Comp

**COMPLETED**

Map No. \_\_\_\_\_ Sec. 24 Twp. 9 R. 19W

Well No. 5 Jelinek

Derby etal.

Company

**FIRST REPORT**

Contractor

C S L SW SW

**SECTION PLAT**

\_\_\_\_\_ Ft. from N. Line

330 Ft. from S. Line

\_\_\_\_\_ Ft. from E. Line

660 Ft. from W. Line


Rooks County

Location X

Rig up \_\_\_\_\_

Drilling and Remarks: \_\_\_\_\_

**RECORD**

Cased \_\_\_\_\_ in., \_\_\_\_\_ ft.

Sand \_\_\_\_\_

Gas \_\_\_\_\_

Oil \_\_\_\_\_

Total Depth \_\_\_\_\_

**PRODUCTION**

1st 24 hrs. Nat. \_\_\_\_\_

1st 24 hrs. after shot \_\_\_\_\_

Gas \_\_\_\_\_ Cu. Ft.

Dry Hole \_\_\_\_\_

Abandoned \_\_\_\_\_

Date

JAN 12 1949 19

S. J. LEWIS

Scout

