


Section 24 Township 9 Range 19WWell No. #1 StuckyCompany Mid-Plains

NORTH

WEST

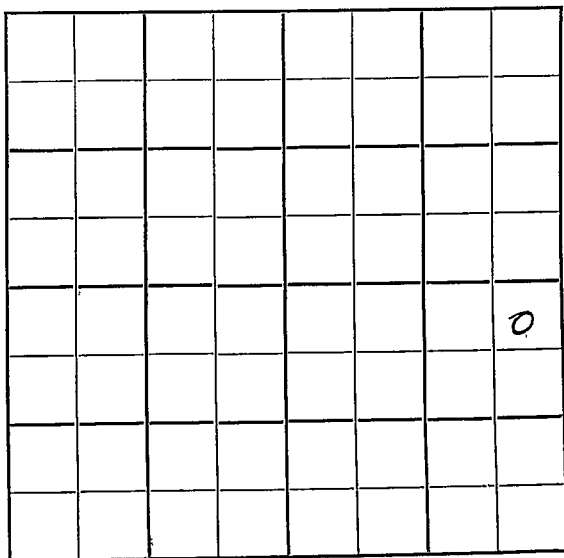

EAST

SOUTH

Rooks

KANSAS

Sec. 24 Twp. 9 R. 19W

Well No. #1 Stucky Farm

Mid-Plains Company

Wildcat

330 Ft. from N. Line


Ft. from S. Line

330 Ft. from E. Line

Ft. from W. Line

NE NE SE

Sinclair DHM

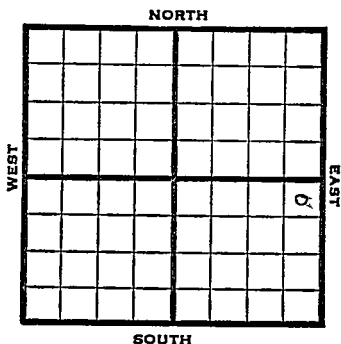

1951 Elev. 2197' REPORT

10/24 Location

1952
1/9

Spud 11-7-51
Oil well TD 3616' 8" @ 284
Anhy 1575' Heeb 3329' KC 3369'
Arb. 3611-16 5" @ 3613' TD 3616'
FU 1620' oil 7½ hr. S/28 BO 4 hr.
Comp. 116 BOPD

COMPLETED

County **Rooks** State **Kansas**

Sec. 24 (Blk. Twp.) 9 (Sur. Rge.) 19W Map No.

Operator **Mid-Plains**

Well No. **1** Farm **Stucky**

Elev.	Location	NE	NE	SE
-------	----------	----	----	----

FIRST REPORT

330 Ft. From N Line SE

330 Ft. From E Line Quarter

1st. Report OCT 24 1951

Completion. _____

Remarks Sinclair DEM


Spudding Date _____

Drig. Data Wildcat

Location

J. E. TYRA

County _____ Rocks _____ State **Kansas**
 Sec. **24** (Blk.) **9** (Sur.) **19W** Map No. _____
 Operator **Mid-Plains**
 Well No. **1** Farm **Stucky**
 Elev. **2197** Location **NE NE SE**

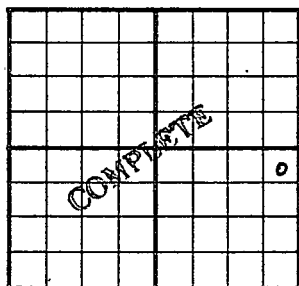

330 Ft. From **N** Line **SE**
330 Ft. From **E** Line **Quarter**
 Ist. Report _____
 Completion **JAN 9 1952**
 Remarks **Wildcat**

Spudding Date **11-7-51**

Drlg. Data **Oil well** **TD 3616**
8" @ 284 **Anhy 1575** **Heeb. 3329**
KC 3369 **Arb. 3611-16** **5" @ 3613**
TD 3616 **FU 1620' oil 7½ hr.**
S/ 28 bo 4 hr. **Comp. 116 bopd**

J. E. TYRA