

Section 24 Township 9 Range 19W

Well No. #2 Thyfault

Company Skelly Oil

NORTH

	0						

WEST

EAST

SOUTH

Sec. 24 Twp. 9 R. 19W

Well No. #2 Thyfault Farm

Skelly Oil Company

Contractor Jellinek


330' Ft. from N. Line

_____ Ft. from S. Line

_____ Ft. from E. Line

330' Ft. from W. Line

NW NW NW

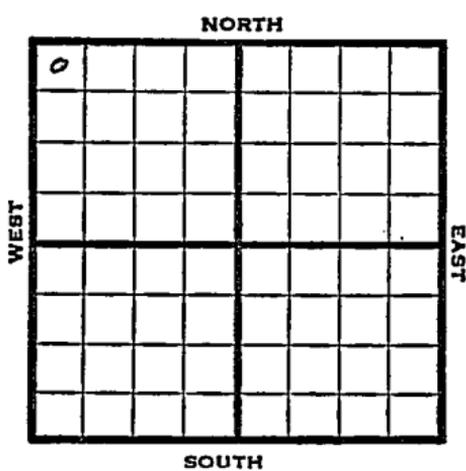

1952 Elev. 2104' REPORT

2/6 Location
 2/13 . "
 2/20 8" @ 292' WOC
 3/5 Heeb 3232'
 Tor. 3254'
 Lans 3277'
 Stain @ 3437-41' & 3446-50'
 Arb. 3514-17' RTD
 5" @ 3515 WOC
 3/12 DP to 3517' Fill up 1600' oil 2 hrs.
 P/109 BO 6 hrs. P/286 BO plus 16 BW
 16 hrs. Testing
 3/19 Spud 2-15-52
 Oil Well TD 3517 8" @ 292
 Heeb. 3232 Tor. 3254
 Lans. 3277 Stain 3437-41
 3446-50 Arb. 3514-17
 5" @ 3515' DP to 3517
 FU 1600' oil 2 hr. P/ 109 bo 6 hr.
 P/ 286 bo 18 bw 16 hr.
 Comp. 1969 bopd 25% wtr.

COMPLETED

County Reeks State Kansas

Sec. 24 (Blk. 9 (Sur. 19W Twp.) (Rge.) Map No.

Operator Skelly Oil

Well No. 2 Farm Thyfault

Elev. _____ Location NW NW NW

0				

FIRST REPORT

330 Ft. From N Line NW

380 Ft. From W Line Quarter

1st. Report FEB 6 1952

Completion _____

Remarks _____

Spudding Date _____

Drlg. Data Jellinek

Location

J. G. McGEHEE

County _____ Rooks _____ State **Kansas**

Sec. **24** (Blk. Twp.) **9** (Sur. Rge.) **19W** Map No. _____

Operator **Skelly Oil**

Well No. **2** Farm **Thyfault**

Elev. **2104** Location **NW NW NW**

D					

COMPLETE

330 Ft. From **N** Line **NW**
 330 Ft. From **W** Line **Quarter**

Ist. Report _____

Completion **MAR 19 1952**

Remarks **Jellinek Pool**

Spudding Date **2-15-52**

Drilg. Data **Oil well TD 3517**

8" @ 292 Heeb. 3232 Tor. 3254

Lans. 3277 Stain 3437-41 3446-50

Arb. 3514-17 5" @ 3515 DP to 3517

FU 1600' oil 2 hr. P/ 109 bo 6 hr.

P/ 286 bo 18 bw 16 hr.

Comp. 1969 bopd 25% water