

Section 24 Township 9 Range 20W

Well No. #1 Choquette

Company Continental

Wildcat

NORTH

0							

4

WEST

EAST

SOUTH

Sec. 24 **KANSAS** Twp. 9 R. 20W

Well No. #1 Choquette Farm  
Continental Company

**Wildcat**


330 Ft. from N. Line

\_\_\_\_\_ Ft. from S. Line

\_\_\_\_\_ Ft. from E. Line

330 Ft. from W. Line

**NW/c**

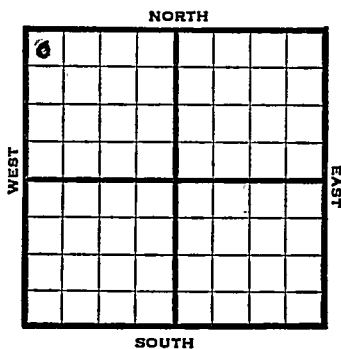

1947 Elev. 2168' REPORT

10/22 SH

11/5  
Lans. 3424'  
Cong. 3700'  
Arbuckle 3828'  
Total Depth 3867'

**ABANDONED**

Map No. \_\_\_\_\_ Sec. 24 Twp. 9 R. 20W

Well No. 1 Choguette

Continental Company

FIRST REPORT Contractor

NW/C


SECTION PLAT

330 Ft. from N. Line

\_\_\_\_\_ Ft. from S. Line

\_\_\_\_\_ Ft. from E. Line

330 Ft. from W. Line

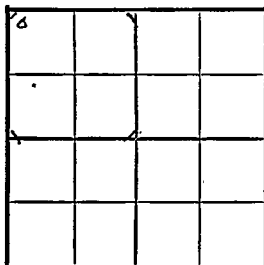

Rooks County

Location \_\_\_\_\_

Rig up \_\_\_\_\_

Drilling and Remarks:

SH

RECORD

Cased \_\_\_\_\_ in., \_\_\_\_\_ ft.

Sand \_\_\_\_\_

Gas \_\_\_\_\_

Oil \_\_\_\_\_

Total Depth \_\_\_\_\_

PRODUCTION

1st 24 hrs. Nat. \_\_\_\_\_

1st 24 hrs. after shot \_\_\_\_\_

Gas \_\_\_\_\_ Cu. Ft.

Dry Hole \_\_\_\_\_

Abandoned \_\_\_\_\_

Date

OCT 22 1947 19

S. J. LEWIS Scout

Map No. 65 Kansas Sec. 24 Twp. 9 R. 20W

Well No. 1 Choquette

Continental Company

**ABANDONED**

Contractor

NW/C

*E 1, 2, 168*  
SECTION PLAT

330 Ft. from N. Line

\_\_\_\_\_ Ft. from S. Line

\_\_\_\_\_ Ft. from E. Line

330 Ft. from W. Line

6			

Rooks County

Location \_\_\_\_\_

Rig up \_\_\_\_\_

Drilling and Remarks:

*Law 3424*

*Comp 3700*

*Oil 3825*

RECORD

Cased \_\_\_\_\_ in., \_\_\_\_\_ ft.

Sand \_\_\_\_\_

Gas \_\_\_\_\_

Oil \_\_\_\_\_

Total Depth 3867

PRODUCTION

1st 24 hrs. Nat. \_\_\_\_\_

1st 24 hrs. after shot \_\_\_\_\_

Gas \_\_\_\_\_ Cu. Ft.

Dry Hole \_\_\_\_\_

Abandoned \_\_\_\_\_

Date

NOV 5 1947 19

S. J. LEWIS Scout