

KANSAS

Graham

FORM 51 25M 3-49 PETROL

Section 24 Township 9 Range 21W

Well No. 2 Barry

Company Skelly

Barry

NORTH

WEST

EAST

							0

SOUTH

9

KANSAS

Graham

Sec. 24 Twp. 9 R. 21W

Well No. #2 Barry Farm

Skelly

Company

Barry Pool


990' Ft. from N. Line

Ft. from S. Line

330' Ft. from E. Line

Ft. from W. Line

SE NE SE

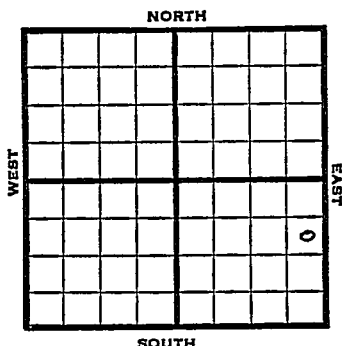

1949

Elev 2250'

REPORT

4/27

Location

5/4

"

5/10

"

5/18

"

5/25

8" @ 299'

Drlg 2875'

6/1

Drlg 3824'

6/7

Lansing 3528'

Congl 3794'

Simpson 3814'

Arbuckle 3826'

TD 3830'

5' @ 3827'

6/15

"

6/21

TD 3855'

10 gals W/PH 12 hrs.

Plug 3831'

6/28

PB 3828'

7/6

550 acid

7/13

TD 3835'

Arb. 3826'

Aband.

ABANDONED

Kansas

Barry Pool

Map No. _____ Sec. 24 Twp. 9 R. 21WWell No. 2 Barry

_____ Skelly _____ Company

FIRST REPORT

_____ Contractor

SE NE SE


SECTION PLAT

990 Ft. from N. Line

_____ Ft. from S. Line

330 Ft. from E. Line

_____ Ft. from W. Line

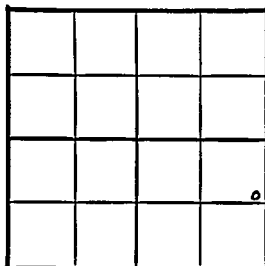

Graham County

Location X

Rig up _____

Drilling and Remarks:

RECORD

Cased _____ in., _____ ft.

Sand _____

Gas _____

Oil _____

Total Depth _____

PRODUCTION

1st 24 hrs. Nat. _____

1st 24 hrs. after shot _____

Gas _____ Cu. Ft.

Dry Hole _____

Abandoned _____

Date

APR 27 1949 19 _____S. J. LEWIS Scout

Kansas

Barry Pool

Map No. K65 Sec. 24 Twp. 9 R. 21WWell No. 2 BarrySkelly

Company

ABANDONED

Contractor

SE NE SE

E1,2250
SECTION PLAT990 Ft. from N. Line Ft. from S. Line330 Ft. from E. Line Ft. from W. Line

			0

Graham County

Location Rig up

Drilling and Remarks:

Per 3826.**RECORD**Cased in., ft.Sand Gas Oil Total Depth 29835**PRODUCTION**1st 24 hrs. Nat. 1st 24 hrs. after shot Gas Cu. Ft.Dry Hole Abandoned

Date

JUL 13 1949 19S. J. LEWIS

Scout