


Section 24 Township 9 Range 21 W

Well No. # 1 Cochran

Company Barnett Oil

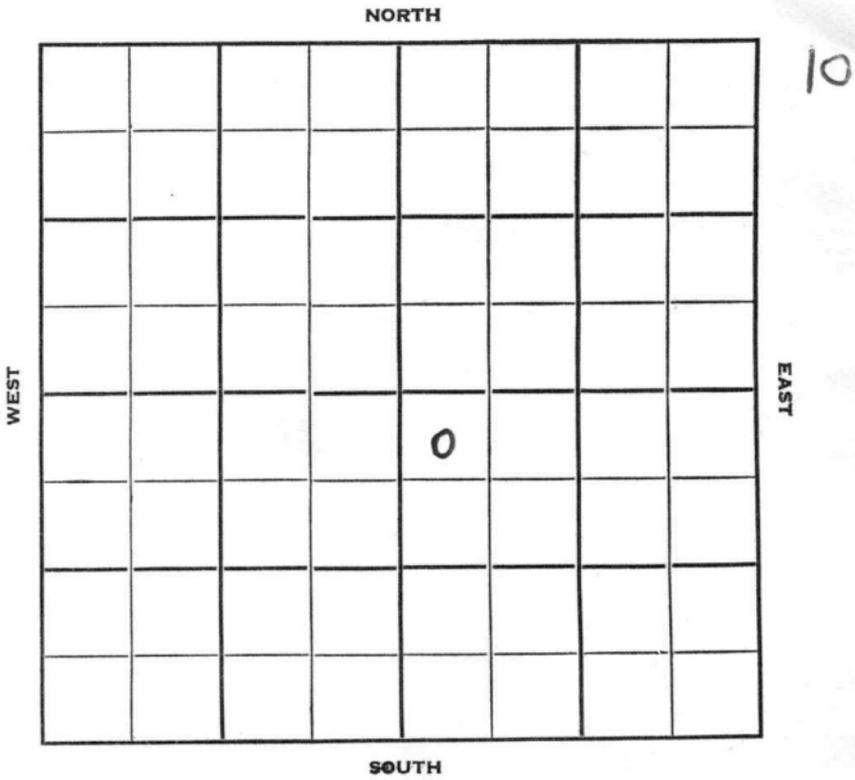

Sec. 24 Twp. 9 R. 21W

Well No. #1 Cochran Farm

Barnett Oil Company

Barnett Drlg. Contractor

Morel Pool


330 Ft. from N. Line

_____ Ft. from S. Line

_____ Ft. from E. Line

330 Ft. from W. Line

NW NW SE

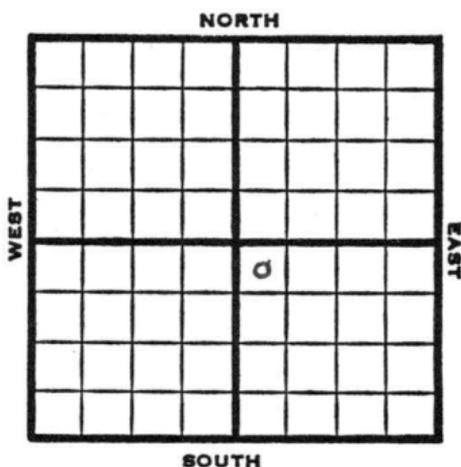

1953 Elev. 2226' REPORT

6/24 Spud 5-20-53
8" @ 159'
WOC.

7/1 Drlg. 3470'

7/8 Spud 5-20-53

D & A

TD 3789'

8" @ 159'

Heeb 3441, Lans 3482, B KC 3716,

Cong 3746, Arb 3778

DST 3776-89 opn 1 hr, rec 2200' sw
1098#

TD 3789'

D & A

ABANDONED

County Graham State KansasSec. 24 (Blk. Twp.) 9 (Sur. Rge.) 21W Map No.Operator Barnett OilWell No. 1 Farm CochranElev. Location NW NW SE330 Ft. From N Line SE330 Ft. From W Line Quarter1st. Report JUN 24 1953

Completion

Remarks

Barnett Drlg. - Contr.Spudding Date 5-20-53Drlg. Data Morel Pool8" @ 159 WOC

