

Rooks

FORM 51 IOM 12-46 PETROL

Section 25 Township 9 Range 16W

Well No. 1 Beiser

Company Cities Service

0									

NORTH

WEST

EAST

SOUTH

Sec. 25 Twp. 9 R. 16-W

Well No. #1 Beiser Farm.

Cities Service Company

Laton Pool


 Ft. from N. Line

330 Ft. from S. Line

 Ft. from E. Line

330 Ft. from W. Line

SW/C

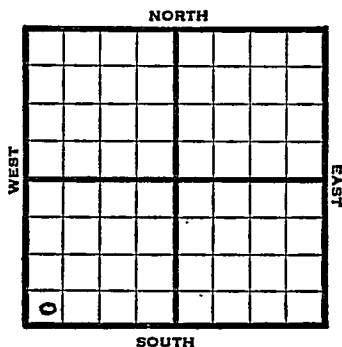

1947

Elev 2050'

REPORT

6/11

8" @ 200'
Drlg. 969'

6/21

Drlg 2878'

6/25

TD 3609'
Lans 3217'
Arbuckle 3593'
Abandoned

ABANDONED

Map No. _____ Sec. 25 Twp. 9 R. 16W

Well No. 1 Beiser


Cities Service Company

FIRST REPORT

Contractor

SW/C

SECTION PLAT

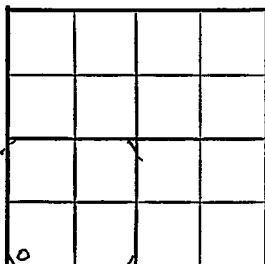

_____ Ft. from N. Line

330 Ft. from S. Line

_____ Ft. from E. Line

330 Ft. from W. Line

Rooks County

Location _____

Rig up _____

Drilling and Remarks:

8" @ 200

drlg. 969

RECORD

Cased _____ in., _____ ft.

Sand _____

Gas _____

Oil _____

Total Depth _____

PRODUCTION

1st 24 hrs. Nat. _____

1st 24 hrs. after shot _____

Gas _____ Cu. Ft.

Dry Hole _____

Abandoned _____

Date

JUN 11 1947 19 S. J. LEWIS Scout

Map No. 64 Sec. 25 Twp. 9 R. 16W

Well No. 1 Beiser

Cities Service Company

ABANDONED

Contractor

SW/C


F1.2058
SECTION PLAT

 Ft. from N. Line

330 Ft. from S. Line

 Ft. from E. Line

330 Ft. from W. Line

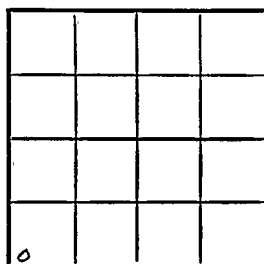

Rooks County

Location

Rig up

Drilling and Remarks:

Lane 3217

Per 82593

RECORD

Cased in, ft.

Sand

Gas

Oil

Total Depth 3609

PRODUCTION

1st 24 hrs. Nat.

1st 24 hrs. after shot

Gas Cu. Ft.

Dry Hole

Abandoned

Date

JUN 25 1947 19 S. J. LEWIS Scout