

# KANSAS

Rooks

Section 25 Township 9 Range 19W

Well No. 2 Benoit "B"

Company Bay Pet 5  
Jelinek

NORTH

|   |  |  |  |  |  |  |  |
|---|--|--|--|--|--|--|--|
|   |  |  |  |  |  |  |  |
|   |  |  |  |  |  |  |  |
| o |  |  |  |  |  |  |  |
|   |  |  |  |  |  |  |  |
|   |  |  |  |  |  |  |  |
|   |  |  |  |  |  |  |  |
|   |  |  |  |  |  |  |  |
|   |  |  |  |  |  |  |  |

WEST

EAST

SOUTH

KANSAS Rooks

Sec. 25 Twp. 9 R. 19W ✓

Well No. #2 Benoit "B" Farm

Bay Pet. Company

Jelinek Pool


\_\_\_\_\_ Ft. from N. Line

990' \_\_\_\_\_ Ft. from S. Line

\_\_\_\_\_ Ft. from E. Line

330' \_\_\_\_\_ Ft. from W. Line

NW SW NW

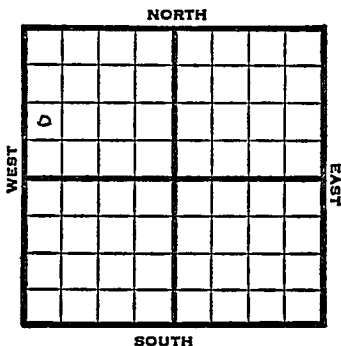

1949

Elev 2199' REPORT

3/30  
4/6

RUR  
8" @ 263'  
Drlg 2700'  
TD 3664'  
Lans. 3377'  
Arb. 3648'  
Aband.

**ABANDONED**

4/13

Kansas

Map No. \_\_\_\_\_ Sec. 25 Twp. 9 R. 19WWell No. 2 Benoit "B"

\_\_\_\_\_ Bay Pet. \_\_\_\_\_ Company

\_\_\_\_\_ **FIRST REPORT** \_\_\_\_\_ Contractor

NW SW NW

**SECTION PLAT**

\_\_\_\_\_ Ft. from N. Line

990 Ft. from S. Line

\_\_\_\_\_ Ft. from E. Line

330 Ft. from W. Line

|   |  |  |  |
|---|--|--|--|
|   |  |  |  |
| o |  |  |  |
|   |  |  |  |
|   |  |  |  |

Rooks County

**RECORD**

Location \_\_\_\_\_

Cased \_\_\_\_\_ in., \_\_\_\_\_ ft.

Rig up \_\_\_\_\_

Sand \_\_\_\_\_

Drilling and Remarks:

Gas \_\_\_\_\_

Oil \_\_\_\_\_

Total Depth \_\_\_\_\_

R U R

**PRODUCTION**

1st 24 hrs. Nat. \_\_\_\_\_

1st 24 hrs. after shot \_\_\_\_\_

Gas \_\_\_\_\_ Cu. Ft.

Dry Hole \_\_\_\_\_

Abandoned \_\_\_\_\_

Date

MAR 30 194919S. J. LEWISScout

