Rooks KANSAS


DX 78-1

Section 25 Township 9 Range 19W

Well No. 5 Baumgartner

Company Grant Oil

7

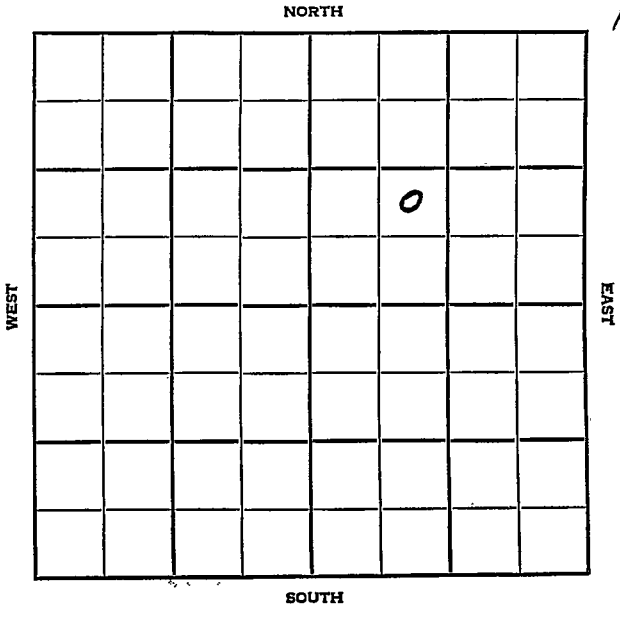

Rooks KANSAS

SEC.	TWP.	R.
25	9	19W

WELL NO.

5 Baumgartner FARM

COMPANY

Grant Oil

CONTRACTOR


Empire Drlg.

_____ Ft. from N. Line

990 Ft. from S. Line

_____ Ft. from E. Line

990 Ft. from W. Line

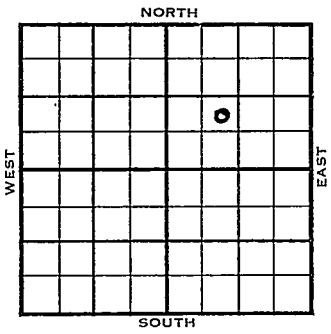

NE SW NE

	ELEVATION	REPORT
1954	2199'	

7/28 Spdg 7-27-54
8" @ 156
WOC

8/25 Spud 7-27-54
Oil Well
TD 3613'
8" @ 156'
Top 3116', Heeb 3325', Tor 3349',
Lans 3367', Arb.3608'
TD 3613'
5" @ 3610'
CO to 3613'
S/40 boph 2 hrs.
Comp. 3000 bopd

COMPLETED

DX-78

FORM 275 FOR SALE BY KANSAS-BLUE PRINT CO.


County Rooks State Kansas

Sec. 25 (Blk. Twp.) 9 (Sur. Rge.) 19W Map No.

Operator Grant Oil

Well No. 5 Farm Baumgartner

Elev. Location NE SW NE

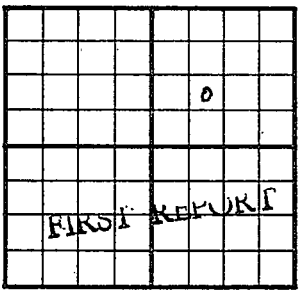

990 Ft. From S Line NE

990 Ft. From W Line Quarter

1st. Report JUL 2 8 1954

Completion

Remarks Empire - Contr.

Spudding Date 7-27-54

Drlg. Data

8" @ 156 WOC

J. G. McGEHEE

FORM 275 FOR SALE BY KANSAS BLUE PRINT CO.


County Rooks State Kansas

Sec. 25 (Blk. Twp.) 9 (Sur. Rge.) 19W Map No.

Operator Grant Oil

Well No. 5 Farm Baumgartner

Elev. 2199 Location NE SW NE

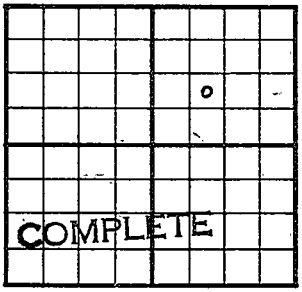

990 Ft. From S Line NE

990 Ft. From W Line Quarter

1st. Report

Completion AUG 25 1954

Remarks

Empire - Contr.

Spudding Date 7-27-54

Drlg. Data Oil well TD 3613

8" @ 156 Top. 3116 Heeb. 3325

Tor. 3349 Lans. 3367 Arb. 3608

TD 3613 5" @ 3610 CO to 3613

S/ 40 boph 2 hr. Comp. 3000 bopd

FABEN GILSTRAP