
FORM 51 25M 8-50 WESTERN R ooks

Section 25 Township 9 Range 19W

Well No. #3 Baumgartner

Company Grant Oil

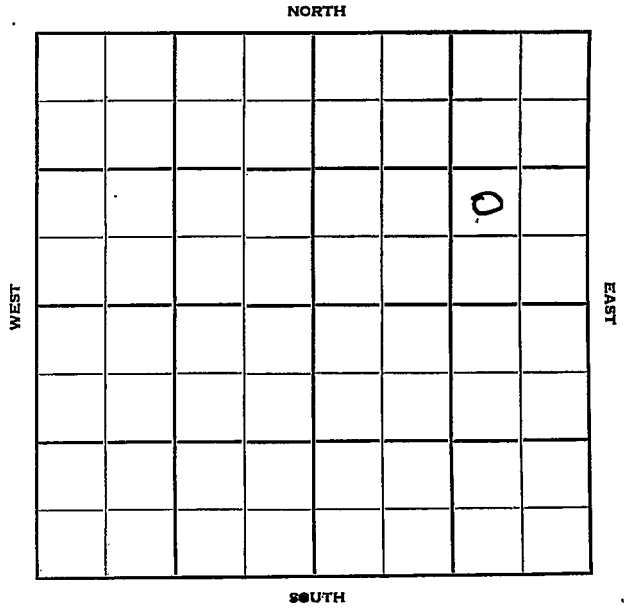

FORM 252-B
10M 8-51 TPCO.

Rooks KANSAS ✓

Sec. 25 Twp. 9 R. 19 W

Well No. # 3 Baumgartner Farm

Grant Oil Company

Peak Contractor


Ft. from N. Line

990 Ft. from S. Line

990 Ft. from E. Line

Ft. from W. Line

NW SE NE

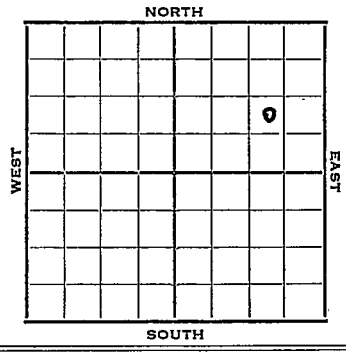

1952	Elev. 2201' REPORT
6/18	Rigging up
6/25	8" @ 240' Anhy 1545' Drlg. 3335'
7/2	Arb. 3613 RTD 3617 5" @ 3614 DP 3617 S/5 Boph POP
7/9	NR
7/17	"
7/23	(Back dope: Lans. 3371 DST 3290-3335 1 hr. 30' m & SSO)
7/30	NR
8/6	"
8/13	"
8/20	P/5 BOPH
8/27	NR
9/4	Spud 6-17-52 Oil Well TD 3617' 8" @ 240' Anhy 1545 Lans. 3371 DST 3290-3335' open 1 hr. rec. 30' mud & SO Arb. 3613 TD 3617 5" @ 3614 Comp. 50 bopd COMPLETED

FORM 275 FOR SALE BY KANSAS BLUE PRINT CO.


County Rooks State Kansas

Sec. 25 (Blk. Twp.) 9 (Sur. Rge.) 19W Map No.

Operator Grant Oil

Well No. 3 Farm Baumgartner

Elev. Location NW SE NE

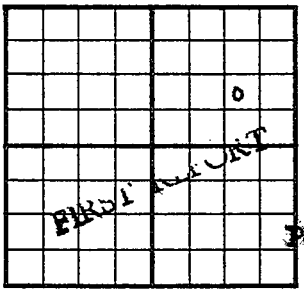

990 Ft. From S Line NE

990 Ft. From E Line Quarter

1st. Report JUN 18 1952

Completion

Remarks

Peak - Contr.

Spudding Date

Drlg. Data

RU

J. G. McGEHEE

FORM 275 FOR SALE BY KANSAS BLUE PRINT CO.


County Rooks State Kansas

Sec. 25 (Blk. Twp.) 9 (Sur. Rge.) 19W Map No.

Operator Grant Oil

Well No. 3 Farm Baumgardner

Elev. 2201 Location NW SE NE

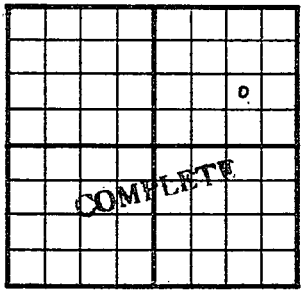

990 Ft. From S Line NE

990 Ft. From E Line Quarter

1st. Report

Completion SEP 4 1952

Remarks

Peak - Contr.

Spudding Date 6-17-52

Drlg. Data Oil well TD 3617

8" @ 240 Anhy 1545 Lans. 3371

DST 3290-3335 open 1 hr. Rec. 30' mud

& SO Arb. 3613 TD 3617 5" @ 3614

Comp. 50 bopd

J. G. McGEHEE