

KANSAS


FORM 51 5M PETROL

Graham

Section 25 Township 9 Range 21-W

Well No. #3 Mesler

Company Bridgeport Pet.

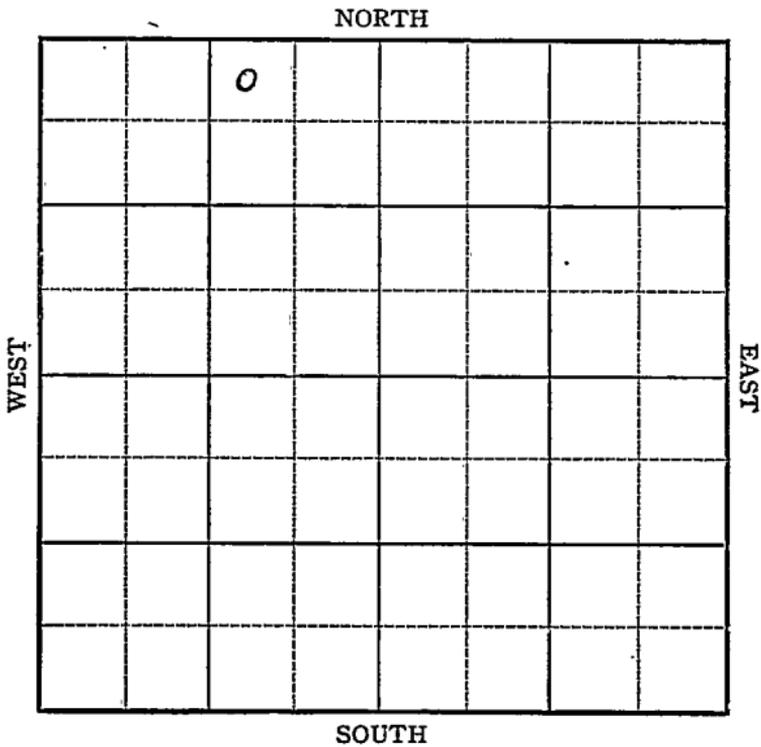


Sec. 25 Twp. 9 R. 21-W

Well No. #3 Fesler Farm

Bridgeport Pet. Company

NORTH

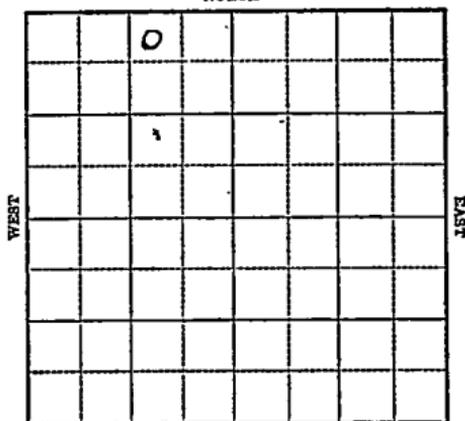

SOUTH

330 Ft. from N. Line

_____ Ft. from S. Line

990 Ft. from E. Line

_____ Ft. from W. Line

Elev. 2237

1943

R E P O R T

10/27 8" @ 215'
Drlg. 2100'

11/3 Anhy 1720
Drlg. 3460'

11/10 Lans 3482
Simp 3816
Arb 3833
T.D. 3837'

ABANDONED

KANSAS

Map No. 65 Sec. 25 Twp. 9 R. 21W

Well No. 3 Fesler

Bridgeport Pet. Company

FIRST REPORT Contractor

NW NE NW

330 Ft. from N. Line

_____ Ft. from S. Line

990 Ft. from E. Line

_____ Ft. from W. Line

SECTION PLAT

	0		

Morel Pool

Location _____

Rig up _____

Drilling and Remarks:

8"-215
2100'

RECORD

Cased _____ in., _____ ft.

Sand _____

Gas _____

Oil _____

Total Depth _____

PRODUCTION

1st 24 hrs. Nat. _____

1st 24 hrs. after shot _____

Gas _____ Cu. Ft.

Dry Hole _____

Abandoned _____

Date

OCT 27 1943 19

S. J. LEWIS Scout

KANSAS
 Map No. 07 Sec. 25 Twp. 9 R. 21W

Well No. 3 Fesler

Bridgeport Pet. Company

ABANDONED Contractor

NW NE NW

330 Ft. from N. Line

_____ Ft. from S. Line

990 Ft. from E. Line

_____ Ft. from W. Line

SECTION PLAT

/	o		

Morel Pool

Location _____

Rig up _____

Drilling and Remarks:

Lows 3482

Scup 3816

Cr 83833

RECORD

Cased _____ in., _____ ft.

Sand _____

Gas _____

Oil _____

Total Depth 3737

PRODUCTION

1st 24 hrs. Nat. _____

1st 24 hrs. after shot _____

Gas _____ Cu. Ft.

Dry Hole _____

Abandoned _____

Date

NOV 10 1943 19

S. J. LEWIS Scout