

KANSAS


FORM 51 5M 1-42 PETROL

Graham

Section 25 Township 9 Range 21 ~~W~~

Well No. #1 Ray Fesler

Company Hollow

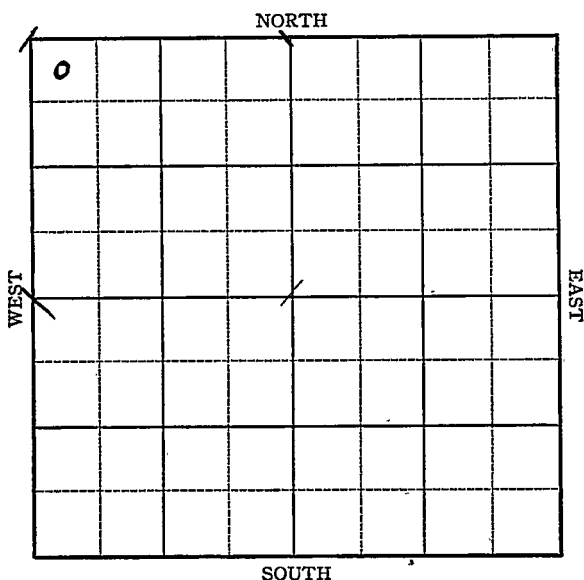


KANSAS

Graham

Sec. 25 Twp. 9 R. 21-WWell No. #1 Ray Fesler FarmHollow Company

Wildcat

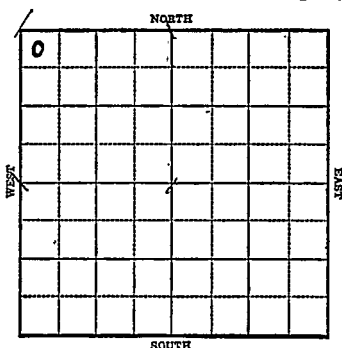330 Ft. from N. Line Ft. from S. Line Ft. from E. Line330 Ft. from W. LineElev. 2294

1943

R E P O R T

6/16	Cellar
6/23	"
6/30	"
7/7	"
7/15	8" @ 240' WOC.
7/21	SD
7/28	"
8/4	"
8/11	Drlg. 2476'
8/18	Drlg. 2918' Anhy 1698'
8/25	Topeka 3200 Lans 3451 BKC 3674 Drlg. 3735'
9/2	Cong 3722 Simp Sd 3745 Simp Dolo 3651 Ars 3764 T.D. 3768 Sat 5" @ 3764' Rust
9/8	1000 acid 2600' oil

OVER

1943

9/15 Arb 3762
5" @ 3762
1000 acid
Echo Pot. 1904'
T.D. 3768'
Gravity 26

COMPLETED

Graham

Map No. KAN 575 Sec. 25 Twp. 9 R. 21WWell No. 1 Ray FeslerHollow

Company

FIRST REPORT

Contractor

NW/C


330 Ft. from N. Line

Ft. from S. Line

Ft. from E. Line

330 Ft. from W. Line

SECTION PLAT

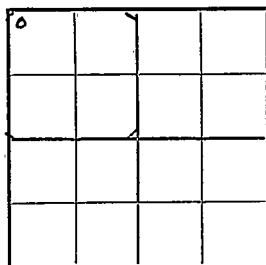

WILDCAT

Location

Rig up

Drilling and Remarks:

Cellar

RECORD

Cased _____ in., _____ ft.

Sand _____

Gas _____

Oil _____

Total Depth _____

PRODUCTION

1st 24 hrs. Nat. _____

1st 24 hrs. after shot _____

Gas _____ Cu. Ft.

Dry Hole _____

Abandoned _____

Date

JUN 16 1943 19

S. J. LEWIS Scout

KANSAS
Map No. 65 Sec. 25 Twp. 9 R. 21WWell No. 1 Ray FeslerHollow CompanyCOMPLETED Contractor

NW/C

330 Ft. from N. Line Ft. from S. Line Ft. from E. Line330 Ft. from W. Line

SECTION PLAT

0			

WildcatLocation Rig up

Drilling and Remarks:

At 837625" @ 87621000 AcidEchoed 190426 1/2

RECORD

Cased in., ft.Sand Gas Oil Total Depth 8762

PRODUCTION

1st 24 hrs. Nat. 1st 24 hrs. after shot Gas Cu. Ft.Dry Hole Abandoned

Date

SEP 15 1943 19S. J. LEWIS

Scout