DX 78-1

Graham


KANSAS

Section 25 Township 9 Range 22W

Well No. #1 Gustafson

Company ~~Petroleum Inc.~~

8

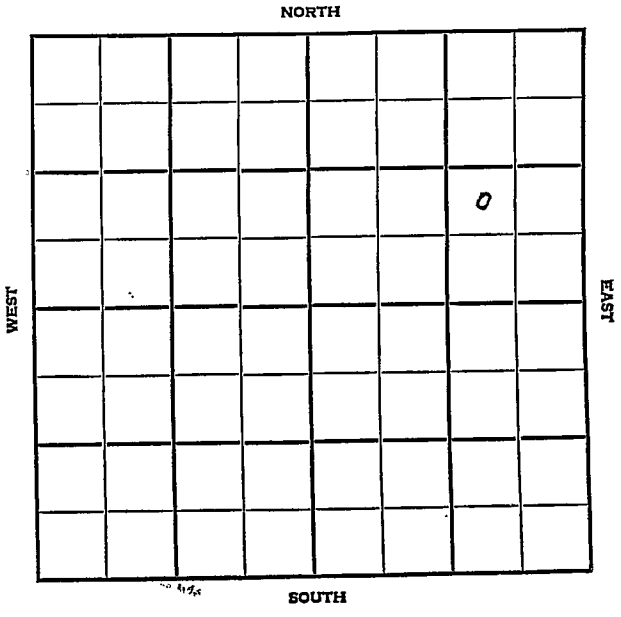

Graham KANSAS

SEC.	TWP.	R.
25	9	22W

WELL NO. #1 Gustafson FARM

COMPANY Petroleum Inc.

CONTRACTOR

Garvey

Wildcat.


_____ Ft. from N. Line

990 Ft. from S. Line

990 Ft. from E. Line

_____ Ft. from W. Line

NW SE NE

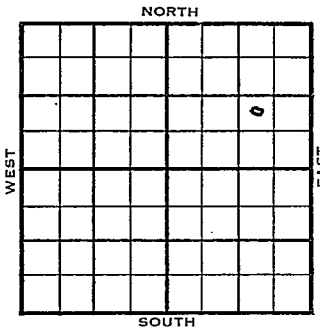

	ELEVATION	
1954	2371'	REPORT

12/22 Spud 12-19-54
8" @ 204'
Drlg. 1680'

1955
1/5 Spud 12-19-54
D & A
TD 3942'
8" @ 204'
Heeb 3551', Tor 3576'
DST 3578'-3665' opn 1 hr, rec 510' msw, 750#
DST 3655'-3748' opn 1 hr, rec 100' Mud 1000 #
DST 3740'-3818' opn 1 hr, rec 45' vsocm 1050#
Arb. 3930'
DST 3931'-42' opn 1 hr, rec 555' s.w. 270#
TD 3942'
D& A

ABANDONED

DX-78-

FORM 275 FOR SALE BY KANSAS BLUE PRINT CO.


County Graham State Kansas

Sec. 25 (Blk. Twp.) 9 (Sur. Rge.) 22W Map No.

Operator Petroleum Inc.

Well No. 1 Farm Gustafson

Elev. 2371 Location NW SE NE

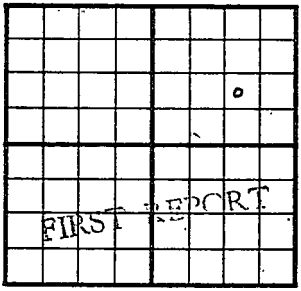

990 Ft. From S Line NE

990 Ft. From E Line Quarter

1st. Report DEC 22 1954

Completion

Remarks

Garvey - Contr.

Spudding Date 12-19-54

Drlg. Data Wildcat

8" @ 204 drlg. 1680

FABEN GILSTRAP

FORM 275 FOR SALE BY KANSAS BLUE PRINT CO.


County Graham State Kansas

Sec. 25 (Blk. Twp.) 9 (Sur. Rge.) 22W Map No.

Operator Petroleum Inc.

Well No. 1 Farm Gustafson

Elev. 2373 Location NW SE NE

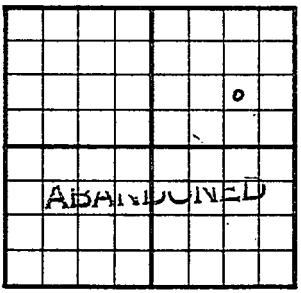

990 Ft. From S Line NE

990 Ft. From E Line Quarter

1st. Report

Completion JAN 5 1955

Remarks Wildcat

Garvey - Contr.

Spudding Date 12-19-54

Drlg. Data D & A TD 3942

8" @ 204 Heeb. 3551 Tor. 3576

DST 3578-3665 open 1 hr. Rec. 510' msw

750# DST 3655-3748 open 1 hr. Rec.

100' mud 1000# DST 3740-3818

open 1 hr. Rec. 45' vsocm 1050#

Arb. 3930 DST 3931-42 open 1 hr.

Rec. 555' sw 270# TD 3942

D & A

FABEN GILSTRAP