


Section 25 Township 9 Range 22 W

Well No. #2 Gustafson

Company Jones, Shelburne & Farmer

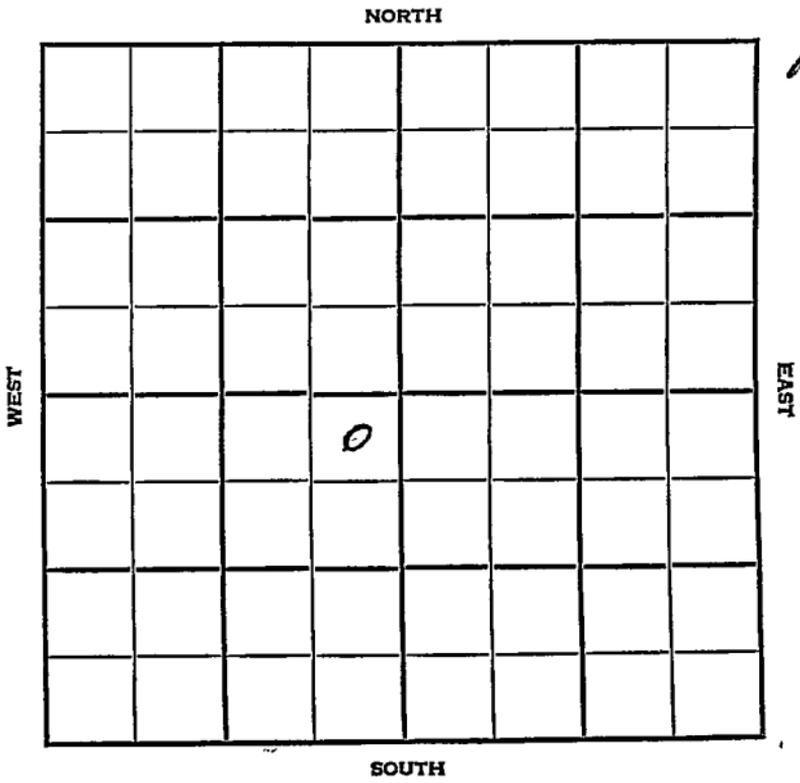

Graham

KANSAS

SEC. 25	TWP. 9	R.. 22W
------------	-----------	------------

WELL NO. #2 Gustafson FARM

COMPANY Jones, Shelburne & Farmer

CONTRACTOR Co. Tools

Ironclad


_____ Ft. from N. Line

_____ Ft. from S. Line

_____ Ft. from E. Line

_____ Ft. from W. Line

NE NE SW

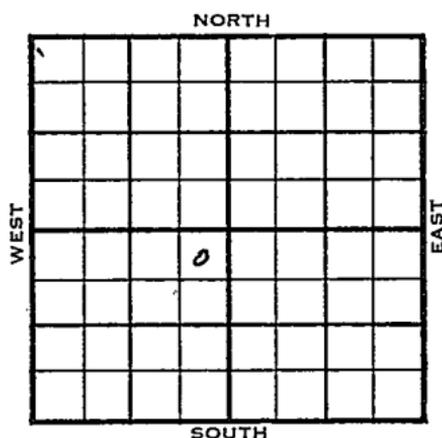

1955

ELEVATION

2353'

REPORT

10/12

Comm 10-9-55

8" @ 167

Drlg 1815

10/26

Comm 10-9-55

8" @ 167

H

3527

Tr

3551

L

3567

BKC

3786

A

3921

DST 3572-95 open 1/2 hr

Rec 23' drlg mud 570#

D & A

ABANDONED

County Graham Elev. _____
 Sec. 25 Twp. 9N Rge. 22W
 Company Jones, Shelburne & Farmer
 FarmName Gustafson No. 2

TOPS	DEPTH	LOG	DATUM	Loc. in Sec. _____									
Anh.				NE1/4 NW1/4 SW1/4									
Tp.													
H.													
Tr.													
Dg.													
Bl.													
L.				Geol. _____									
K.C.				Contr. _____									
B.K.C.													
Ce.													
C.				Co. tools									
M.													
M.				Pool									
K.													
Mz.				Ironclad									
Mq.				<table border="1"> <tr> <td></td> <td>o</td> <td></td> </tr> <tr> <td colspan="3" style="text-align: center;">FIRST REPORT</td> </tr> <tr> <td colspan="3" style="text-align: center;">OCT 12 55</td> </tr> </table>		o		FIRST REPORT			OCT 12 55		
	o												
FIRST REPORT													
OCT 12 55													
V.													
S.													
S.													
A.													
R.													
PE.													
G.													
T.D.													

Date Comm. 10-9-55
8" @ 167 drlg. 1815

[Handwritten signature]

Co.
Lse.
No.
Sec.
T.
R.

County Graham Elev. 2353
 Sec. 25 Twp. 9 Rgs. 22W
 Company Jones, Shelburne & Farmer
 Farm Name Gustafson No. 2

TOPS	DEPTH	LOG	DATUM
Anh.			
Tp.			
H.	<u>3527</u>		<u>1174</u>
Tr.	<u>3557</u>		<u>1198</u>
Dg.			
BL.			
L.	<u>3567</u>		<u>1214</u>
K.C.			
B.K.C.	<u>3786</u>		<u>1433</u>
Ce.			
C.			
M.			
M.			
K.			
Mz.			
Mq.			
V.			
S.			
S.			
A.	<u>3921</u>		<u>1568</u>
R.			
PE.			
G.			
T.D.			

Loc. in Sec. NE NE SW
 Geol. _____
 Contr. _____
 Co. tools _____
 Pool _____
Ironclad

ABANDONED		
0		

Date Comm. 10-9-55 : OCT 26 1955

8" @ 167 DST 3572-95 open 1/2 hr.

Rec. 23' drlg. mud; 570#

D & A

Co. Sec. T. R.