

KANSAS DRILLERS State Geological Survey  
 State Geological Survey  
 API No. 15 WICHITA BRANCH 065 — 20,756  
 County Number

S. 17 T. 9 R. 25 <sup>W</sup><sub>E</sub>  
 Loc. NE NW SE  
 County Graham

Operator  
Helberg Oil Co.

Address  
Box 32, Morland, Kansas 67650


Well No. 771 Lease Name Rodney Martin

Footage Location  
330 feet from (N)  line 990 feet from  (W) line

Principal Contractor Helberg Oil Company Geologist Roger Welty

Spud Date June 17, 1975 Total Depth 4090 P.B.T.D.

Date Completed June 30, 1975 Oil Purchaser

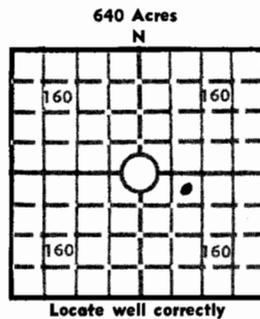

Locate well correctly  
 Elev.: Gr. \_\_\_\_\_  
 DF \_\_\_\_\_ KB 2623

**CASING RECORD**

Report of all strings set — surface, intermediate, production, etc.

Purpose of string	Size hole drilled	Size casing set (in O.D.)	Weight lbs/ft.	Setting depth	Type cement	Sacks	Type and percent additives
Surface	12 $\frac{1}{4}$	8 5/8	#28	212	Common	135	

**LINER RECORD**

**PERFORATION RECORD**

Top, ft.	Bottom, ft.	Sacks cement	Shots per ft.	Size & type	Depth interval

**TUBING RECORD**

Size	Setting depth	Packer set at

**ACID, FRACTURE, SHOT, CEMENT SQUEEZE RECORD**

Amount and kind of material used	Depth interval treated

**INITIAL PRODUCTION**

Date of first production \_\_\_\_\_ Producing method (flowing, pumping, gas lift, etc.) \_\_\_\_\_

RATE OF PRODUCTION PER 24 HOURS	Oil	Gas	Water	Gas-oil ratio
	bbls.	MCF	bbls.	CFPB
Disposition of gas (vented, used on lease or sold)			Producing interval (s)	

INSTRUCTIONS: As provided in KCC Rule 82-2-125, within 90 days after completion of a well, one completed copy of this Drillers Log shall be transmitted to the State Geological Survey of Kansas, 4150 Monroe Street, Wichita, Kansas 67209. Copies of this form are available from the Conservation Division, State Corporation Commission, 3830 So. Meridian (P.O. Box 17027), Wichita, Kansas 66217. Phone AC 316-522-2206. If confidential custody is desired, please note Rule 82-2-125. Drillers Logs will be on open file in the Oil and Gas Division, State Geological Survey of Kansas, Lawrence, Kansas 66044.

Operator

Helberg Oil Company

DESIGNATE TYPE OF COMP.: OIL, GAS, DRY HOLE, SWDW, ETC.:

Well No.

1

Lease Name

Rodney Martin

Dry hole

S 17 T 9 R 25 <sup>K</sup>/<sub>W</sub>

**WELL LOG**

Show all important zones of porosity and contents thereof; cored intervals, and all drill-stem tests, including depth interval tested, cushion used, time tool open, flowing and shut-in pressures, and recoveries.

SHOW GEOLOGICAL MARKERS, LOGS RUN, OR OTHER DESCRIPTIVE INFORMATION.

FORMATION DESCRIPTION, CONTENTS, ETC.	TOP	BOTTOM	NAME	DEPTH
See attached copy of geologist report				

USE ADDITIONAL SHEETS, IF NECESSARY, TO COMPLETE WELL RECORD.

Date Received



*Jerry M. Helberg*  
 \_\_\_\_\_  
 Signature  
 \_\_\_\_\_  
 Owner  
 \_\_\_\_\_  
 Title  
 \_\_\_\_\_  
 July 8, 1975  
 \_\_\_\_\_  
 Date