


Rooks

KANSAS

SECTION 26 TOWNSHIP _____ RANGE 9S 16W

WELL NO. #1 Reece

COMPANY Burch Drlg.

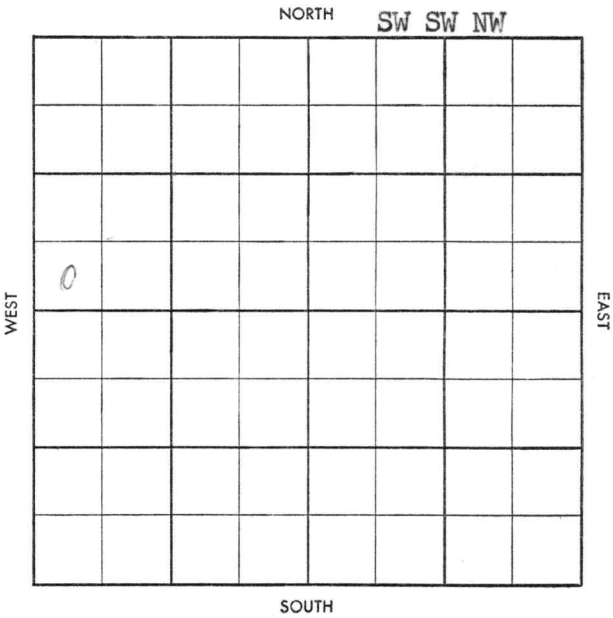

~~Wildcat~~
 Wildcat
 Co. Facet

S-513-B

County Rooks Elev. 2042
 Sec. 26 Twp. 9 Rge. 16W
 Company Burch Drlg.
 Farm Name Reece No. 1

| TOPS | DEPTH | LOG | DATUM |
|--------|-------|-----|-------|
| Anh. | | | |
| Tp. | | | |
| H. | 3155 | | |
| Tr. | 3178 | | |
| Dg. | | | |
| B.L. | | | |
| L. | 3198 | | |
| K.C. | | | |
| B.K.C. | | | |
| Ce. | | | |
| C. | | | |
| M. | | | |
| M. | | | |
| K. | | | |
| Mz. | | | |
| Mq. | | | |
| V. | | | |
| S. | | | |
| S. | | | |
| A. | | | |
| R. | | | |
| Pf. | | | |
| G. | | | |
| T.D. | | | |

Loc. in Sec. SW SW NW
 Geol. _____
 Contr. _____
Co. tools
 Pool Wildcat



Date Comm. 7-29-58
8" @ 198 DST 3192-3250 open 1 1/2 hr.
rec. 46' mud 1200/30" DST 3250-3300
open 1 hr., rec. 167' mud 70' swcm
1160/30" drlg.

Co.
Lse.
No.
Sec.
T.
R.

Twp. HO Pool.


Co. Facet. HO

S-513-B

County Rooks Elev. 2042'
 Sec. 26 Twp. 9 Rge. 16W
 Company Burch Drlg.
 Farm Name Reece No. 1

| TOPS | DEPTH | LOG | DATUM |
|--------|-------------|-----|-------|
| Anh. | | | |
| Tp. | | | |
| H. | <u>3155</u> | | |
| Tr. | <u>3175</u> | | |
| Dg. | | | |
| B.L. | | | |
| L. | <u>3198</u> | | |
| K.C. | | | |
| B.K.C. | | | |
| Ce. | | | |
| C. | <u>3529</u> | | |
| M. | | | |
| M. | | | |
| K. | | | |
| Mz. | | | |
| Mq. | | | |
| V. | | | |
| S. | | | |
| S. | | | |
| A. | <u>3596</u> | | |
| R. | | | |
| Pf. | | | |
| G. | | | |
| T.D. | <u>3617</u> | | |

Loc. in Sec. 31 SW 1/4
 Geol. _____
 Contr. _____
 Co. tools _____
 Pool wildcat

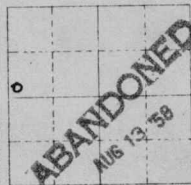

Date Comm. 7-22-58
 6" @ 198 DST 3192-3250 open 1 hr.
 rec. 16' mud 1200/30" DST 3250-3300
 open 1 hr., rec. 167' mud 70' swm
 1160/30" drlg. AUG 13 '58 run log

DOA

Co.

Lse.

No.

Sec.

T.

R.