

Sec. 26 Twp. 9 R. 19W ✓

Well No. #1 Benorise Farm
Bay Pet. Company

Chandler Pool

NORTH


330' Ft. from N. Line

_____ Ft. from S. Line

330' Ft. from E. Line

_____ Ft. from W. Line

NE/C

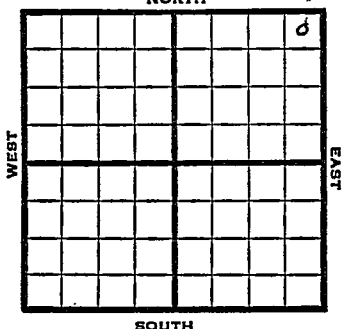

1948

Elev 2169' REPORT

12/15 Surface Hole
12/22 8" @ 238'
Drlg 2670'
12/29 Drlg 3365'
1/5 Lansing 3337'
Arbuckle 3375'-78'
TD 3378'
5" @ 3576'
1/12 2200' oil 4 hrs
1/19 TD 3579' 500 acid
Swb 200 bbls oil 5 hrs.
1/26 "
2/2 "
2/9 Swb 40 oil PH 5 hrs.
2/16 "
2/23 "
3/2 "
3/8 "
3/16 TD 3579'
Arb 3575'
5" @ 3576'
500 acid
Depth Pot 1656'
27° Gr.
Comp

COMPLETED

Map No. _____ Sec. 26 Twp. 9 R. 19W

Well No. 1 Benorise

Bay Pet. _____ Company

FIRST REPORT Contractor

NE/C

SECTION PLAT

330 Ft. from N. Line

_____ Ft. from S. Line

330 Ft. from E. Line

_____ Ft. from W. Line

			o

Rooks County

Location _____

Rig up _____

Drilling and Remarks:

surface hole

RECORD

Cased _____ in., _____ ft.

Sand _____

Gas _____

Oil _____

Total Depth _____

PRODUCTION

1st 24 hrs. Nat. _____

1st 24 hrs. after shot _____

Gas _____ Cu. Ft.

Dry Hole _____

Abandoned _____

Date

DEC 15 1948 19

S. J. LEWIS Scout

Kansas

Chandler Pool

Map No. K65 Sec. 26 Twp. 9 R. 19W

Well No. 1 Benorise

Bay Pet. Company

COMPLETE

Contractor

NE/C

E12169
SECTION PLAT

330 Ft. from N. Line

 Ft. from S. Line

330 Ft. from E. Line

 Ft. from W. Line

			0

Rooks County

Location

Rig up

Drilling and Remarks:

*Case 3525
5" case 3576
500000
Depth 3576*

27 e & u

RECORD

Cased in., ft.

Sand

Gas

Oil

Total Depth 3576

PRODUCTION

1st 24 hrs. Nat.

1st 24 hrs. after shot

Gas Cu. Ft.

Dry Hole

Abandoned

Date

MAR 16 1949 19

S. J. LEWIS

Scout