


Section 26 Township 9 Range 20W

Well No. 4 - Marcotte

Company Nadel & Gussman

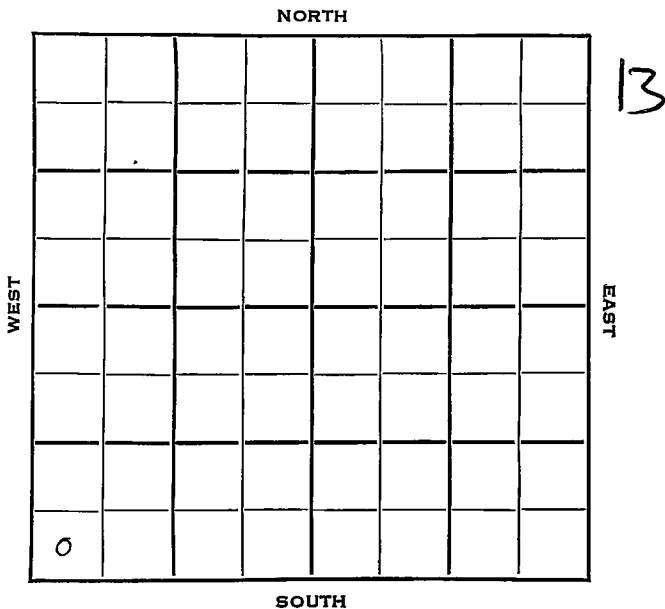



Sec. 26 Twp. 9 R. 20W

Well No. 4 Marcotte Farm

Nadel & Gussman Company

Contractor


Ft. from N. Line

330 Ft. from S. Line

Ft. from E. Line

330 Ft. from W. Line

SW SW SW

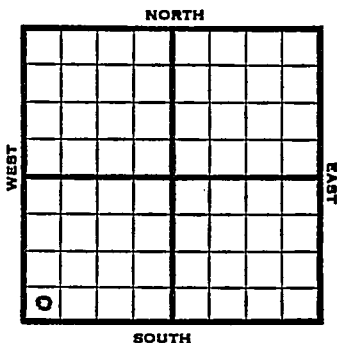

1953 Elev. 2262' REPORT

4/1 Spud 3-30-53
 4/9 10" @ 174'
 Anhy 1736, Heeb 3482
 Drlg 3492'
 4/16 Lans 3522, Cong 3776, Simp 3800,
 Arb. 3823
 RTD 3829
 7" @ 3824'
 4/23 CO 3829
 FU 2600' oil 1 hr., S/85 BOPH
 1700' OB, POP
 4/30 NR
 5/6 "
 5/13 Spud 3-30-53
 Oil Well
 TD 3829
 10" @ 174'
 Anhy 1736, Heeb 3482, Lans 3522, Cong
 3776, Simp 3800, Arb 3823
 TD 3829
 7" @ 3824'
 CO to 3829 FU 2600' oil 1 hr. S/ 85
 boph
 Comp. 3000 bopd.

COMPLETED

