


Rooks

KANSASSection 26 Township 9 Range 20WWell No. #1 MarcotteCompany Nadel & Gussman

NORTH

WEST

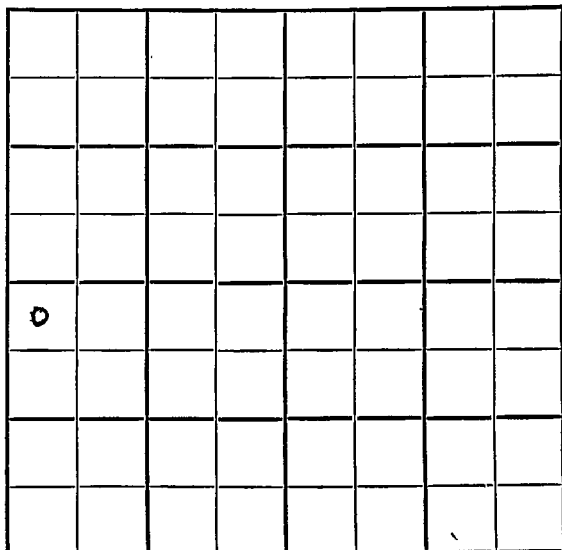

EAST

SOUTH

Sec. 26 Twp. 9 R. 20WWell No. #1 Marcotte FarmNadel & Gussman Company

Wildcat


330 Ft. from N. Line

Ft. from S. Line

Ft. from E. Line

330 Ft. from W. Line

NW SW

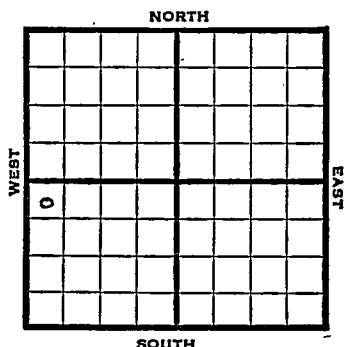

1947

Elev. 2255' REPORT

12/3 Location

12/10 "

12/17 RUR

12/30 8" @ 203'
Drlg. 2590'

1948

1/7 Lansing 3466'
Arbuckle 3803'
TD 3874'1/14 Run csg.
5" @ 3808'
RUST

1/21 "

1/26 Arbuckle 3800' (Corrected)
5" @ 3803'
TD 3814'
Swb 100 bbls oil in 24 hrs

2/4 "

2/11 "

2/18 "

2/25 "

3/3 Arbuckle 3800'
5" @ 3803'
Depth Pot 3000
Gr. 27.5°
Total Depth 3814'**COMPLETED**

Map No. _____ Sec. 26 Twp. 9 R. 20W

Well No. 1 Marcotte

Nadel & Gussman

Company

FIRST REPORT

Contractor

NW SW


SECTION PLAT

330 Ft. from N. Line

_____ Ft. from S. Line

_____ Ft. from E. Line

330 Ft. from W. Line

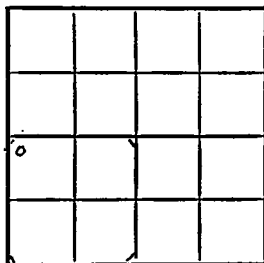

Rooks County

Location X

Rig up _____

Drilling and Remarks:

RECORD

Cased _____ in., _____ ft.

Sand _____

Gas _____

Oil _____

Total Depth _____

PRODUCTION

1st 24 hrs. Nat. _____

1st 24 hrs. after shot _____

Gas _____ Cu. Ft.

Dry Hole _____

Abandoned _____

Date

DEC 3 1947

19

S. J. LEWIS

Scout

Map No. 65 Sec. 26 Twp. 9 R. 20W

Well No. 1 Marcotte

Nadel & Gussman Company

COMPLETE

Contractor

NW SW

E. 2255

SECTION PLAT

330 Ft. from N. Line

 Ft. from S. Line

 Ft. from E. Line

330 Ft. from W. Line

0			

Rooks County

Location

Rig up

Drilling and Remarks:

275500

5" 2255

Dep. 275500

2755

RECORD

Cased in., ft.

Sand

Gas

Oil

Total Depth 2755

PRODUCTION

1st 24 hrs. Nat.

1st 24 hrs. after shot

Gas Cu. Ft.

Dry Hole

Abandoned

Date

MAR 3 1948 19

S. J. LEWIS

Scout