


Section 26 Township 9 Range 20W

Well No: 3 Marcotte

Company Nadel & Gussman

Hampton

NORTH

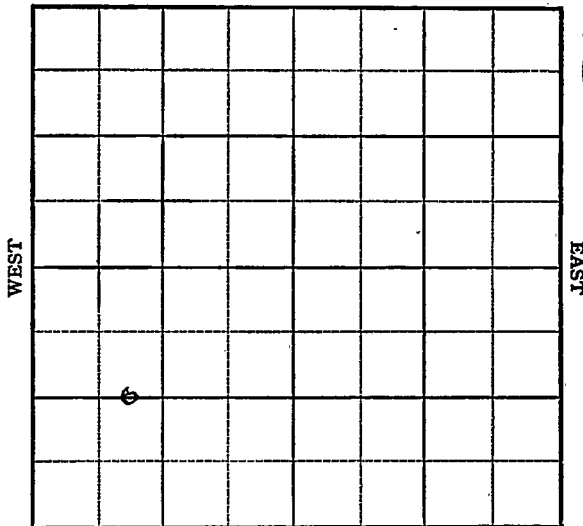

SOUTH

KANSAS

Rooks



Sec. 26 Twp. 9 R. 20W

Well No. #3 Marcotte Farm

Nadel & Gussman

Company


Hampton Pool

_____ Ft. from N. Line

1320' Ft. from S. Line

_____ Ft. from E. Line

990' Ft. from W. Line

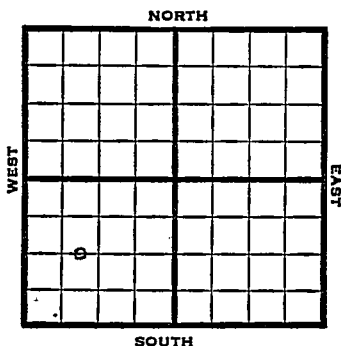

C E L $W\frac{1}{2}$ SW

1949

Elev 2248' REPORT

- 3/2 RUR
- 3/8 8"@ 144
- 3/16 Drlg 2712'
- Arb. 3883'
- TD 3884'
- 5"@ 3883'
- 3/23 Arbuckle 3833 corrected
- 5" @ 3883'
- TD 3884'
- 3/30 "
- 4/6 "
- 4/12 "
- 4/20 "
- 4/27 12 shots 3833-36
- 1600' oil 12 hrs.
- 5/4 "
- 5/11 TD 3884'
- Arb. 3833'
- 5"@ 3883
- Perf
- Pump 104 Oil Pot
- 28° Gr.
- Comp

COMPLETED

Kansas

Map No. _____ Sec. 26 Twp. 9 R. 20WWell No. 3 MarcotteNadel & Gussman Company

FIRST REPORT

Contractor

C E L $W\frac{1}{2}$ SW

SECTION FLAT

_____ Ft. from N. Line

1320 Ft. from S. Line

_____ Ft. from E. Line

990 Ft. from W. Line

Rooks County

Location _____

Rig up _____

Drilling and Remarks:

R U R

RECORD

Cased _____ in., _____ ft.

Sand _____

Gas _____

Oil _____

Total Depth _____

PRODUCTION

1st 24 hrs. Nat. _____

1st 24 hrs. after shot _____

Gas _____ Cu. Ft.

Dry Hole _____

Abandoned _____

Date

MAR 2 1949S. J. LEWIS Scout

