

~~WUBAS~~

Graham ✓

Sec. 26 Twp. 9 R. 21-W

Well No. #1 Cox Farm _____

B & R et al. Company _____


Wildcat

330 Ft. from N. Line

_____ Ft. from S. Line

_____ Ft. from E. Line

990 Ft. from W. Line

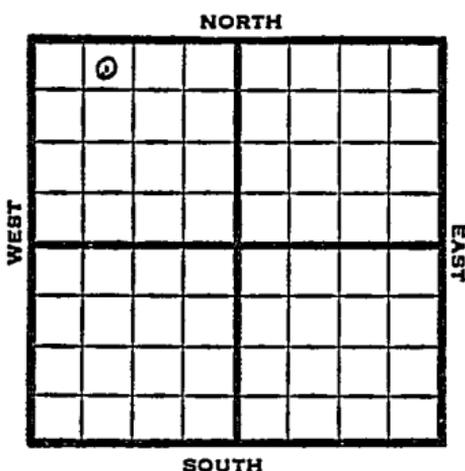

NE NW NW

1948 Elev 2322' REPORT

10/6 RUR

10/13 8"@ 282'

Drig 2525

10/19 Topeka 3532'

Drig 3717'

10/26 Lansing 3532'

Arb. 3831'

5"@ 3831

TD 3835'

11/3 Swb 130 bbls oil 3 hrs

11/10 "

11/16 "

11/23 "

11/30 "

12/8 500 acid

12/15 Pump 20 bbls oil PH

12/22 "

12/29 "

1949 TD 3835'

1/12 Arb. 3831'

5"@ 3831'

500 acid

Pump 140 Oil / 13% W Pot

29° Gr.

Comp

COMPLETED

Map No. _____ Sec. 26 Twp. 9 R. 21W

Well No. 1 Cox

B & R etal. _____ Company

FIRST REPORT _____ Contractor

NE NW NW


SECTION PLAT

330 Ft. from N. Line

_____ Ft. from S. Line

_____ Ft. from E. Line

990 Ft. from W. Line

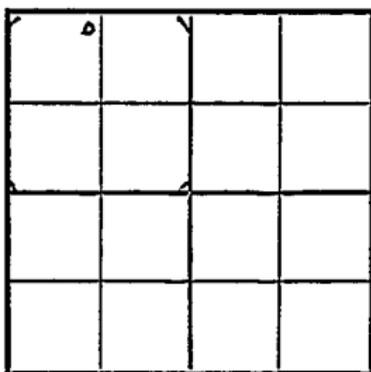

Graham County

Location _____

Rig up _____

Drilling and Remarks:

R U R

RECORD

Cased _____ in., _____ ft.

Sand _____

Gas _____

Oil _____

Total Depth _____

PRODUCTION

1st 24-hrs. Nat. _____

1st 24 hrs. after shot _____

Gas _____ Cu. Ft.

Dry Hole _____

Abandoned _____

Date

OCT 6 1948

19

S. J. LEWIS

Scout

Kansas

Map No. 65 Sec. 26 Twp. 9 R. 21WWell No. I Cox

B & R Etal.

Company

COMPLETE


Contractor

NE NW NW

F12322.
SECTION PLAT330 Ft. from N. Line

Ft. from S. Line

Ft. from E. Line

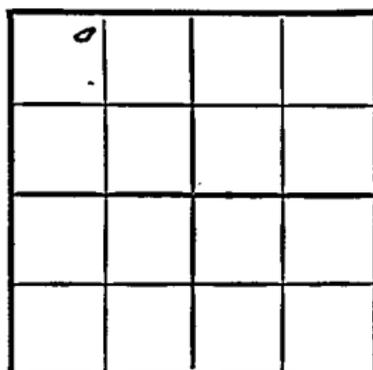990 Ft. from W. Line

Graham County

RECORD

Location

Cased _____ in., _____ ft.

Rig up

Sand _____

Drilling and Remarks:

Gas _____

Oil Total Depth 3135

PRODUCTION

1st 24 hrs. Nat. _____

1st 24 hrs. after shot _____

Gas _____ Cu. Ft.

Dry Hole _____

Abandoned _____

Art 3881
5" @ 3881
5000 cu. ft.
Prod 140 oil 73%
Box
29 9/11

Date

JAN 12 1949 19

S. J. LEWIS

Scout