

Section 26 Township 9 Range 21W

Well No. 2 Cox

Company B & R Drlg.

No Name

NORTH

		o					

WEST

EAST

SOUTH

3



Sec. 26 Twp. 9 R. 21W

Well No. #2 Cox Farm

B & R Drlg. Company


No Name

330' Ft. from N. Line

\_\_\_\_\_ Ft. from S. Line

990' Ft. from E. Line

\_\_\_\_\_ Ft. from W. Line

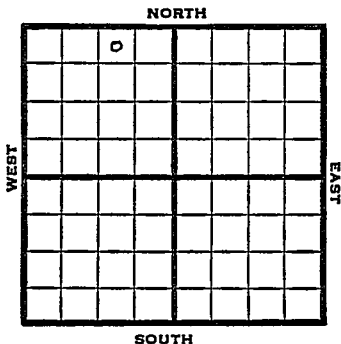

NW NE NW

1948 Elev 2297' REPORT

11/23	RUR
11/30	8"@ 160' Drlg 2460'
12/8	Lansing 3500 Arb. 3813' TD 3816 5"@ 3813'
12/15	"
12/22	"
12/29	TD 3817 500 acid Swb 20 bbls oil PH 7 hrs.
<del>1949</del>	
1/12	TD 3817' Arb 3813' 5"@ 3813 500 acid Pump 84 oil Pot 29° Gr. Comp

**COMPLETED**

Map No. \_\_\_\_\_ Sec. 26 Twp. 9 R. 21W

Well No. 2 Cox

B & R Drlg. Company

### FIRST REPORT

Contractor

NW NE NW

#### SECTION PLAT

330 Ft. from N. Line

	o		

\_\_\_\_\_ Ft. from S. Line

990 Ft. from E. Line

\_\_\_\_\_ Ft. from W. Line

Graham County

Location \_\_\_\_\_

#### RECORD

Rig up \_\_\_\_\_

Cased \_\_\_\_\_ in., \_\_\_\_\_ ft.

Drilling and Remarks:

Sand \_\_\_\_\_

Gas \_\_\_\_\_

Oil \_\_\_\_\_

R U R

Total Depth \_\_\_\_\_

#### PRODUCTION

1st 24 hrs. Nat. \_\_\_\_\_

1st 24 hrs. after shot \_\_\_\_\_

Gas \_\_\_\_\_ Cu. Ft.

Dry Hole \_\_\_\_\_

Abandoned \_\_\_\_\_

Date

NOV 23 1948

19

S. J. LEWIS

Scout

Kansas

Map No. 65 Sec. 26 Twp. 9 R. 21WWell No. 2 Cox. \_\_\_\_\_

B &amp; R Drlg.

Company \_\_\_\_\_

COMPLETE

Contractor \_\_\_\_\_

NW NE NW

E/2297  
SECTION PLAT330 Ft. from N. Line

\_\_\_\_\_ Ft. from S. Line

990 Ft. from E. Line

\_\_\_\_\_ Ft. from W. Line


Graham County

Location \_\_\_\_\_

Rig up \_\_\_\_\_

Drilling and Remarks:

*Cr + 3873**5" @ 3873**500 acid**Pump 14 Oil Prod**290 ft*

## RECORD

Cased \_\_\_\_\_ in., \_\_\_\_\_ ft.

Sand \_\_\_\_\_

Gas \_\_\_\_\_

Oil Total Depth 3917

## PRODUCTION

1st 24 hrs. Nat. \_\_\_\_\_

1st 24 hrs. after shot \_\_\_\_\_

Gas \_\_\_\_\_ Cu. Ft.

Dry Hole \_\_\_\_\_

Abandoned \_\_\_\_\_

Date

JAN 12 1949 19

S. J. LEWIS

Scout