

O. W. D. D

FORM 51 25M 3-49 PETROL

KANSAS

Graham

Section 26 Township 9 Range 21W

Well No. #4  
2 Cox "A"

Company B. & R. Dr/g.  
Derby Oil et al

Morel  
NORTH

WEST

							o

EAST

SOUTH

8

Sec. 26 Twp. 9 R. 21W ✓

Well No. #4 ~~#2~~ Cox "A" Farm

B & R. Drlg.  
~~Derby Oil et al~~ Company

**Morel Pool**


\_\_\_\_\_ Ft. from N. Line

330' Ft. from S. Line

330' Ft. from E. Line

\_\_\_\_\_ Ft. from W. Line

**SE SE NE**

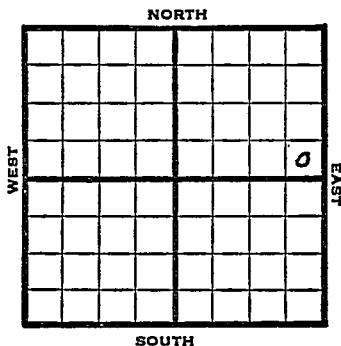

1949

Elev 2246' REPORT

4/20

8" @ 217'

4/27

Drlg 3527'

5/4

TD 3822'

Lans. 3475'

Arb. 3812'

Aband.

**ABANDONED  
O. W. D. D**

1954

6/15

Heeb 3433' Lans 3475' B KC 3706

Cong. 3752 Arb. 3812

OTD 3822 DD 3960'

To DD to Gr. wash for SWDW

6/23

To DD for SWD

6/30

"

7/7

SWD Well

TD 4251'

Heeb 3433'; Lans 3475', B KC 3706',

Cong 3752', Arb. 3812'

OTD 3822'

DD 3960'

DD 4251'

5" @ 3893'

Gr. Wash 4238'

CO to 4251', 3000A

Comp. for SWD Well

**ABANDONED**

Kansas

Map No. \_\_\_\_\_ Sec. 26 Twp. 9 R. 21W

Well No. 2 Cox "A"

Derby Oil etal.

Company

## FIRST REPORT

Contractor

SE NE

## SECTION PLAT

\_\_\_\_\_ Ft. from N. Line

330

\_\_\_\_\_ Ft. from S. Line

330

\_\_\_\_\_ Ft. from E. Line

\_\_\_\_\_ Ft. from W. Line

			o

Graham County

Location \_\_\_\_\_

Rig up \_\_\_\_\_

Drilling and Remarks:

8" @217

## RECORD

Cased \_\_\_\_\_ in., \_\_\_\_\_ ft.

Sand \_\_\_\_\_

Gas \_\_\_\_\_

Oil \_\_\_\_\_

Total Depth \_\_\_\_\_

## PRODUCTION

1st 24 hrs. Nat. \_\_\_\_\_

1st 24 hrs. after shot \_\_\_\_\_

Gas \_\_\_\_\_ Cu. Ft.

Dry Hole \_\_\_\_\_

Abandoned \_\_\_\_\_

Date

APR 20 1949

19

S. J. LEWIS

Scout

Kansas

Map No. K65 Sec. 26 Twp. 9 R. 21W

Well No. 2 Cox "A"

Derby Oil etal. Company

**ABANDONED**

Contractor

SE NE

*E12246*

**SECTION PLAT**

         Ft. from N. Line

330 Ft. from S. Line

330 Ft. from E. Line

         Ft. from W. Line

			6

Graham County

Location                                 

Rig up                                 

Drilling and Remarks:

*Loma 3425*

*Cox 3712*

**RECORD**

Cased            in.,            ft.

Sand                                 

Gas                                 

Oil                                 

Total Depth 3712

**PRODUCTION**

1st 24 hrs. Nat.                                 

1st 24 hrs. after shot                                 

Gas                                  Cu. Ft.

Dry Hole                                 

Abandoned                                 

Date

MAY 4 1949 19

S. J. LEWIS

Scout



**O. W. D. D.**

County **Graham** State **Kansas**

Sec. **26** (Blk. Twp.) **9** (Sur. Rge.) **21W** Map No.

Operator **B & R Drlg. (was Derby)**

Well No. **4** Farm **Cox "A"** (was Derby's #2)

Elev. **2246** Location **SE SE NE**

				0
<b>ABANDONED</b>				

**330** Ft. From **S** Line **NE**  
**330** Ft. From **E** Line Quarter

1st. Report  
 Completion **JUL 7 1954**

Remarks **(OWDD) for SWDW**  
**O. W. D. D.**

Spudding Date

Drlg. Data **SWD well TD 4251**

Heeb. **3433** Lans. **3475** B KC **3706**

Cong. **3752** Arb. **3812** OTD **3822**

DD **3960** DD **4251** **5" @ 3893** gr. wash **4238**

CO to **4251** **3000 A** Comp. for SWD well