


Section 26 Township 9 Range 21-W

Well No. #2 Cox "B"

Company B & R Drlg.

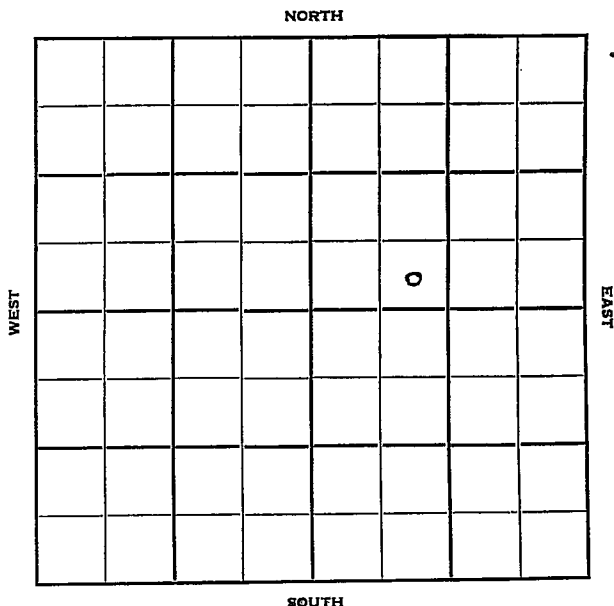

Graham

KANSAS

Sec. 26 Twp. 9 R. 21W

Well No. #2 Cox "B" Farm

B & R Drlg. Company

B & R Drlg. - Contr. Contractor

Morel Pool


Ft. from N. Line

330' Ft. from S. Line

Ft. from E. Line

990' Ft. from W. Line

SE SW NE

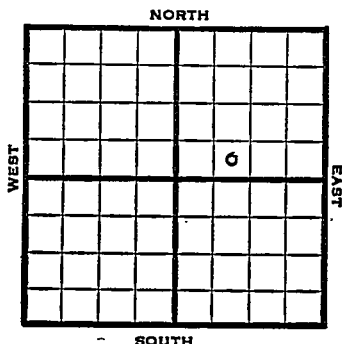

1960

Elev. 2286' REPORT

11/1

Spud 10-25-50
8" @ 177'
Anhy 1745'
Drlg. 2793'

11/22

Spud 10-25-50
SWD Well TD 4263'
8" @ 177' Anhy 1745'
Arb. 3898' TD 4263'
4" @ 3974' 4000 A
Comp. for SWD well
Input 106 bw 12 min

ABANDONED

County Graham State Kansas
 Sec. 26 (Blk.) 9 (Sur.) 21W Map No.
 Operator B & R Drlg.
 Well No. 2 Farm Cox "B"
 Elev. 2286 Location SE SW NE

330 Ft. From S Line NE
990 Ft. From W Line Quarter
 1st. Report NOV 1

Completion

Remarks CRA farmout
B & R Drlg. - Contr.


Spudding Date 10-25-50

Drlg. Data Morel Pool

8" @ 177 Anhy 1745 drlg. 2793

J. E. TYRA

County Graham State Kansas
 Sec. 26 (Blk. 9) (Sur. 21W) Map No. 21W
 Operator B & R Drlg.
 Well No. 2 Farm Cox "B"
 Elev. 2286 Location SE SW NE

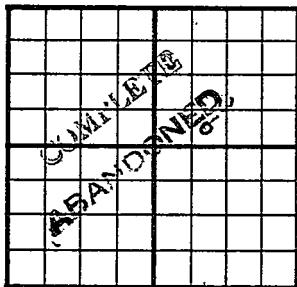

330 Ft. From S Line NE
990 Ft. From W Line Quarter
 Ist. Report
 Completion NOV 22 1950
 Remarks Morel Pool
B & R Drlg. - Contr.
 Spudding Date 10-25-50

Drlg. Data SWD well TD 4263
8" @ 177 Anhy 1745 Arb. 3898 TD 4263
4" @ 3974 4000 A Comp. for SWD well
Input 106 bw 12 min.

J. E. TYRA