

Section 26 Township 9 Range 22-WWell No. #1 Barber "B"Company Cities Service

NORTH

			0				

SOUTH

WEST

EAST

3

KANSAS Graham

Sec. 26 Twp. 9 R. 22-W

Well No. #1 Barber "B" Farm

Cities Service

Company

Rine Drlg.

Contractor


330 Morel Pool
Ft. from N. Line

Ft. from S. Line

330 Ft. from E. Line

Ft. from W. Line

NE NE NW

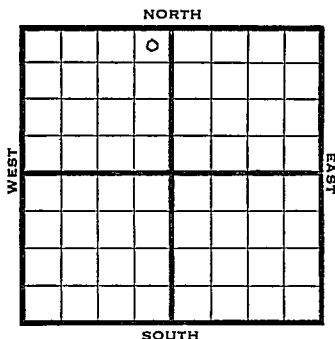

1950

Elev. 2342' REPORT

7/12 Location

9/27 Oil Well TD 3790'
8" @ 240' Heeb 3515' Lans. 3552'
DST 3580-97 opn $\frac{1}{2}$ hr. Rec. 90' free
oil 60' GCM BKG 3773
5" @ 3790' TD 3790'
25/3746-58 1500 A
P/83 BO 134 BW 16 hr
PB 3628 48/3587-99 1500 A
P/168 BO 6 BW 8 hr. Comp. 323 BOPD
2% wtr.

COMPLETED

Kansas

Map No. _____ Sec. 26 Twp. 9 R. 22WWell No. 1 Barber "B"

_____ Cities Service _____ Company

_____ Rine Drlg. _____ Contractor

NE NE NW


_____ 330 _____ Ft. from N. Line

_____ _____ Ft. from S. Line

_____ 330 _____ Ft. from E. Line

_____ _____ Ft. from W. Line

SECTION PLAT

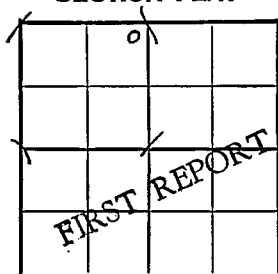

Graham County

Location X

Rig up _____

Drilling and Remarks:

RECORD

Cased _____ in., _____ ft.

Sand _____

Gas _____

Oil _____

Total Depth _____

PRODUCTION

1st 24 hrs. Nat. _____

1st 24 hrs. after shot _____

Gas _____ Cu. Ft.

Dry Hole _____

Abandoned _____


Date

JUL 12 1950

19

J. E. TYRA Scout

County Graham State Kansas
 Sec. 26 (Blk. 9) (Sur. 22W) (Twp. 9) Map No. 22W
 Operator Cities Service
 Well No. 1 Farm Barber "B"
 Elev. 2342 Location NE NE NW

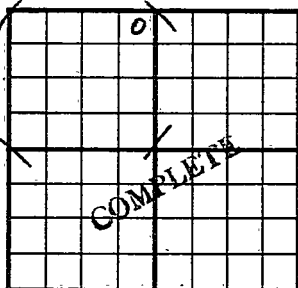

330 Ft. From N Line NW

330 Ft. From E Line Quarter

1st. Report

Completion SEP 27 1950

Remarks Morel Pool

Rine Drlg. - Contr.

Spudding Date

Drlg. Data Oil well TD 3790
8" @ 240 Heeb. 3515 Lans. 3552
DST 3580-97 open $\frac{1}{2}$ hr. Rec. 90' free oil
60' gcm B KC 3773 5" @ 3790 TD 3790
25/ 3746-58 1500 A P/ 83 bo 134 bw 16hr
PF 3628 48/ 3587-99 1500 A P/ 168 bo
6 bw 8 hr. Comp. 323 bopd 2% water

J. E. TYRA