

# KANSAS

Company Peel-Herdman

WEST

## EAST

**SOUTH**

Graham

KANSAS

Sec. 26 Twp. 9 R. 22W

Well No. #2 DeSaire Farm

Peel-Hardman Company

Peel Drlg. Contr. Contractor  
Fargo Pool

Ft. from N. Line

990'


Ft. from S. Line

990'

Ft. from E. Line

Ft. from W. Line

NW SE SE

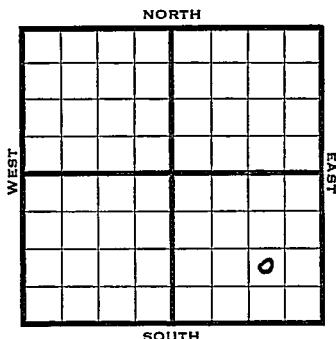

1950

Elv. 2371' REPORT

8/23


Spud 8-19-50  
8" @ 150'  
Drlg. 2000'

10/11

Spud 8-19-50  
Oil Well TD 3972'  
8" @ 150' Heeb 3563' Lans. 3602'  
DST 3635-38 opn  $\frac{1}{2}$  hr Rec. 80' HOCM  
DST 3794-3808 opn 20 min. Rec. 10'  
mud  
BKC 3831' Cong. 3968-72 TD  
5" @ 3845 24/3800-09 500 A  
 $1\frac{1}{2}$  boph PB 3680  
24/3640-49 2000 A  $8\frac{1}{2}$  BOPH  
S/92 BO 10 hr. Comp. 388 BOPD

**COMPLETED**

J. E. TYRA

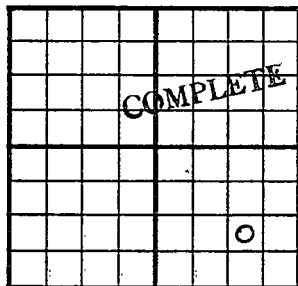County Graham State KansasSec. 26 (Blk.  
Twp.) 9 (Sur.  
Rge.) 22W Map No.Operator Peel - HardmanWell No. 2 Farm DeSaireElev. 2371 Location NW SE SE990 Ft. From S Line SE990 Ft. From E Line Quarter

1st. Report

Completion OCT 11 1950Remarks Fargo PoolPeel Drlg. - Contr.Spudding Date 8-19-50Drlg. Data Oil well TD 39728" @ 150 Heeb. 3563 Lans. 3602DST 3635-38 open  $\frac{1}{2}$  hr. Rec. 80' hoemDST 3794-3808 open 20 min. Rec. 10' mudB KC 3831 Cong. 3968-72TD 5" @ 384524/ 3800-09 500 A 1 $\frac{1}{2}$  boph PB 368024/ 3640-49 2000 A 8 $\frac{1}{2}$  bophS/ 92 bo 10 hr. Comp. 388 bopd

J. E. TYRA