

Section 26 Township 9 Range 22WWell No. 4 Holzhauser "B"Company Cities Service

				o			

NORTH

WEST

EAST

SOUTH



Graham

KANSAS

Sec. 26 Twp. 9 R. 22WWell No. 4 Holzhauser "B" Farm

Cities Service

Company

Rine Drlg - Contr.

Contractor

Iron Glad Pool

Ft. from N. Line

990


Ft. from S. Line

Ft. from E. Line

330

Ft. from W. Line

NW SW NE

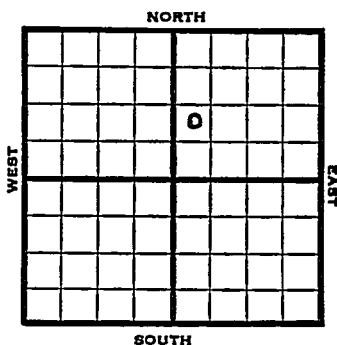

1953

Elev. 2375'

REPORT

4/1

Location

4/9

8" @ 255'

Drlg 3415'

4/16

5" Set

4/23

NR

4/30

P/229 BO + 45 BWPD

5/6

NR

5/20

Spud 4-1-53 Oil well TD 3807

8" @ 255' Top. 3372 Heeb 3544

Dodge 3566 Lans 3581

DST 3583-92 open 1 hr rec 100' O &

GCM, 80' oil 780#

DST 3629-60 open 1 hr rec 30' SOCM

60#

DST 3704-19 open 1 hr. rec 28' mud O#

TD 3807 5" @ 3807 CO to 3789

48/3753-65 41/3620-30 36/3582-91


3500 A P/229 BO 45 BWPD

Comp. 261 BOPD 29% wtr.

COMPLETED

J. G. McGEHEE

County Graham State Kansas
 Sec. 26 (Blk. 9) (Sur. 22W) Map No. 22W
 Operator Cities Service
 Well No. 4 Farm Holzhauer "B"
 Elev. 2375 Location NW SW NE

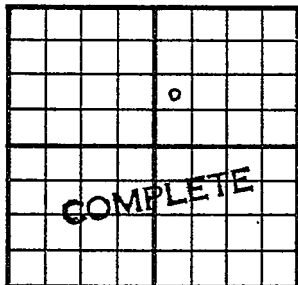

990 Ft. From S Line NE
330 Ft. From W Line Quarter
 Ist. Report
 Completion MAY 20 1953
 Remarks Iron Clad Pool
Rine Drlg. - Comtr.
 Spudding Date 4-1-53

Drlg. Data Oil well TD 3807
8" @ 255 Top. 3372 Heeb. 3544
Dodge 3566 Lans. 3581 DST 3583-92
open 1 hr. Rec. 100' o & gcm 80' oil
780# DST 3629-60 open 1 hr. Rec. 30'
socm 60# DST 3704-19 open 1 hr.
Rec. 28' mud 0# TD 3807 5" @ 3807
CO to 3789 48/ 3753-65 41/ 3620-30
36/ 3582-91 3500-A P/ 229 bo 45 bwpd
Comp. 261 bopd 29% wtr.

J. G. McGEHEE