

STATE CORPORATION COMMISSION OF KANSAS  
OIL & GAS CONSERVATION DIVISION  
WELL COMPLETION OR RECOMPLETION FORM  
ACO-1 WELL HISTORY  
DESCRIPTION OF WELL AND LEASE

Operator: License # 6066  
Name Skyline Petroleum  
Address P. O. Box 70  
Hays, KS 67601  
City/State/Zip

Purchaser

Operator Contact Person Dan Schippers  
Phone 913 625-0020

Contractor: License # 5145  
Name Dreiling Oil, Inc.

Wellsite Geologist Jerry Green  
Phone 913 625-5155

Designate Type of Completion  
 New Well  Re-Entry  Workover  
 Oil  SWD  Temp Abd  
 Gas  Inj  Delayed Comp.  
 Dry  Other (Core, Water Supply etc.)

If OMWO: old well info as follows:  
Operator  
Well Name  
Comp. Date Old Total Depth

WELL HISTORY

Drilling Method:  
 Mud Rotary  Air Rotary  Cable  
3-21-87 4-8-87 4-8-87  
Spud Date Date Reached TD Completion Date  
4100'  
Total Depth PBTD

Amount of Surface Pipe Set and Cemented at 256 feet  
Multiple Stage Cementing Collar Used? Yes  No  
If yes, show depth set feet  
If alternate 2 completion, cement circulated from feet depth to w/SX cmt  
Cement Company Name  
Invoice #

API NO. 15-179-20,890  
County Sheridan  
SW SE SW Sec 29 Twp 9 Rge 26 East  
X West

330 Ft North from Southeast Corner of Section  
3630 Ft West from Southeast Corner of Section  
(Note: Locate well in section plat below)


Lease Name Minium A Well # 1

Field Name

Producing Formation

Elevation: Ground 2645' KB 2650'

Section Plat

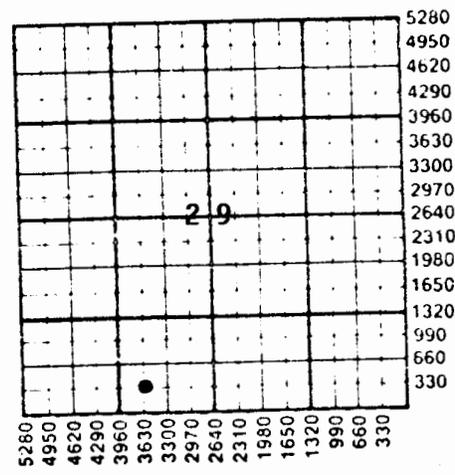

WATER SUPPLY INFORMATION

Disposition of Produced Water: Disposal  
Docket # Repressuring

Questions on this portion of the ACO-1 call:  
Water Resources Board (913) 296-3717

Source of Water:  
Division of Water Resources Permit #

Groundwater 330 Ft North from Southeast Corner  
(Well) 3630 Ft West from Southeast Corner of  
Sec 29 Twp 9 Rge 26 East X West

Surface Water Ft North from Southeast Corner  
(Stream, pond etc) Ft West from Southeast Corner  
Sec Twp Rge East West

Other (explain)  
(purchased from city, R.W.D. #)

INSTRUCTIONS: This form shall be completed in duplicate and filed with the Kansas Corporation Commission, 200 Colorado Derby Building, Wichita, Kansas 67202, within 90 days after completion or recompletion of any well. Rule 82-3-130 and 82-3-107 apply.  
Information on side two of this form will be held confidential for a period of 12 months if requested in writing and submitted with the form. See rule 82-3-107 for confidentiality in excess of 12 months.  
One copy of all wireline logs and drillers time log shall be attached with this form. Submit CP-4 form with all plugged wells. Submit CP-111 form with all temporarily abandoned wells.